


T. 15. R. 9 W. W. M.

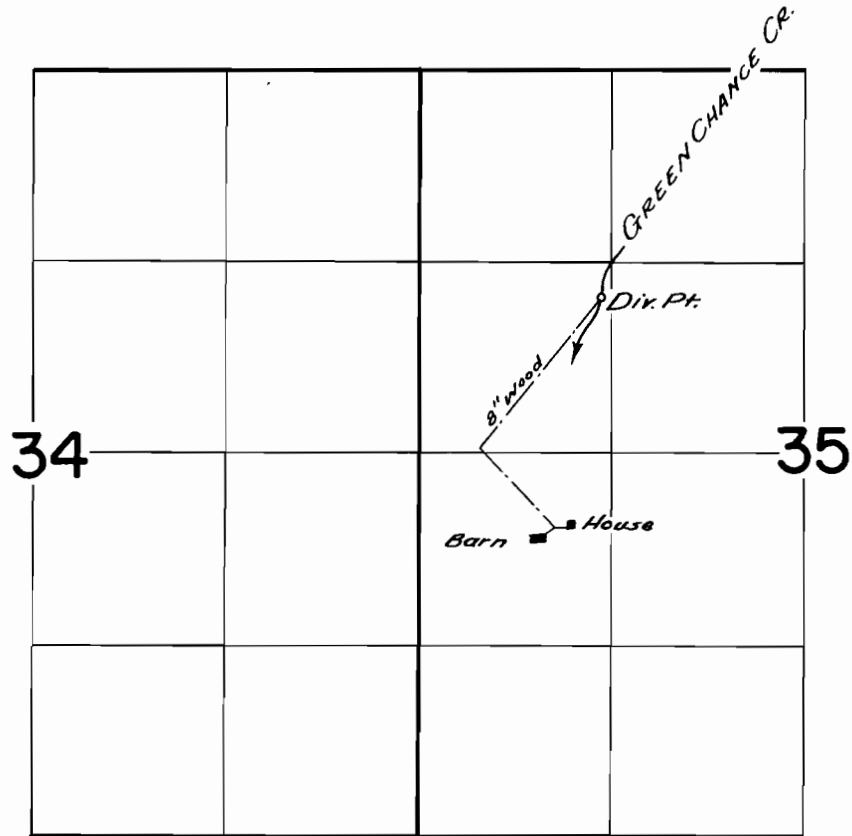

FINAL PROOF SURVEY
UNDER

Power Claim # 341
Application No. *3978* Permit No. *2272*
IN NAME OF

Peter Zirr

Surveyed *June 28 1961* by *COBARTO*