


T.B.S.R. 3 W.W.M.

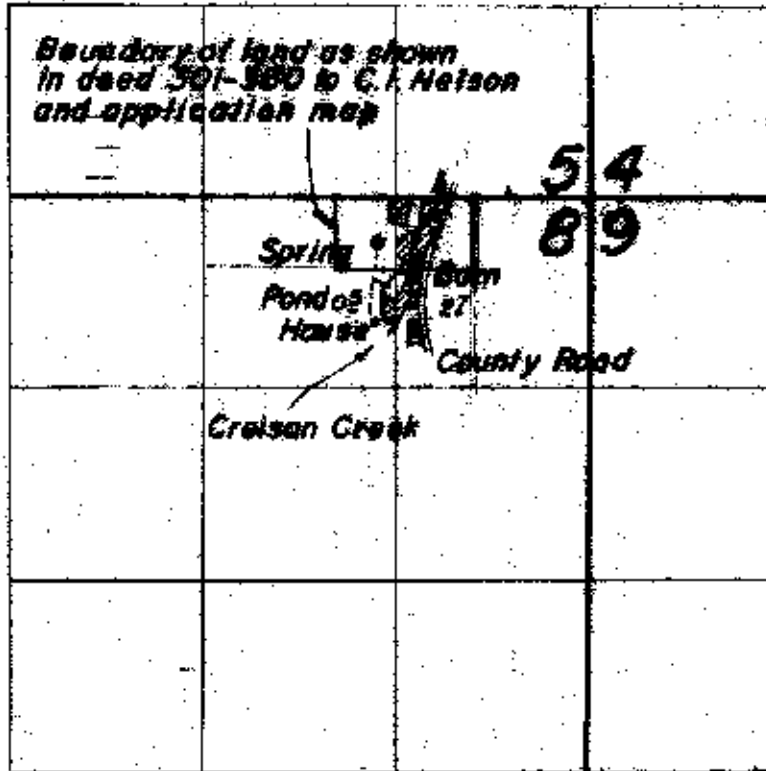

**FINAL PROOF SURVEY**  
UNDER

Application No. 8368 Permit No. 5630  
IN NAME OF

G.L. & Dorothy Nelson

Surveyed July 2, 1963, by Floyd L. Seymour