

Proposed Change in Place of Use


For: HARRY & DAVID

Located in T. 38 S., R. 1 W.W.M.

By: Mark E. Boyden

January, 1962

N.E. cor. D.L.C. 43

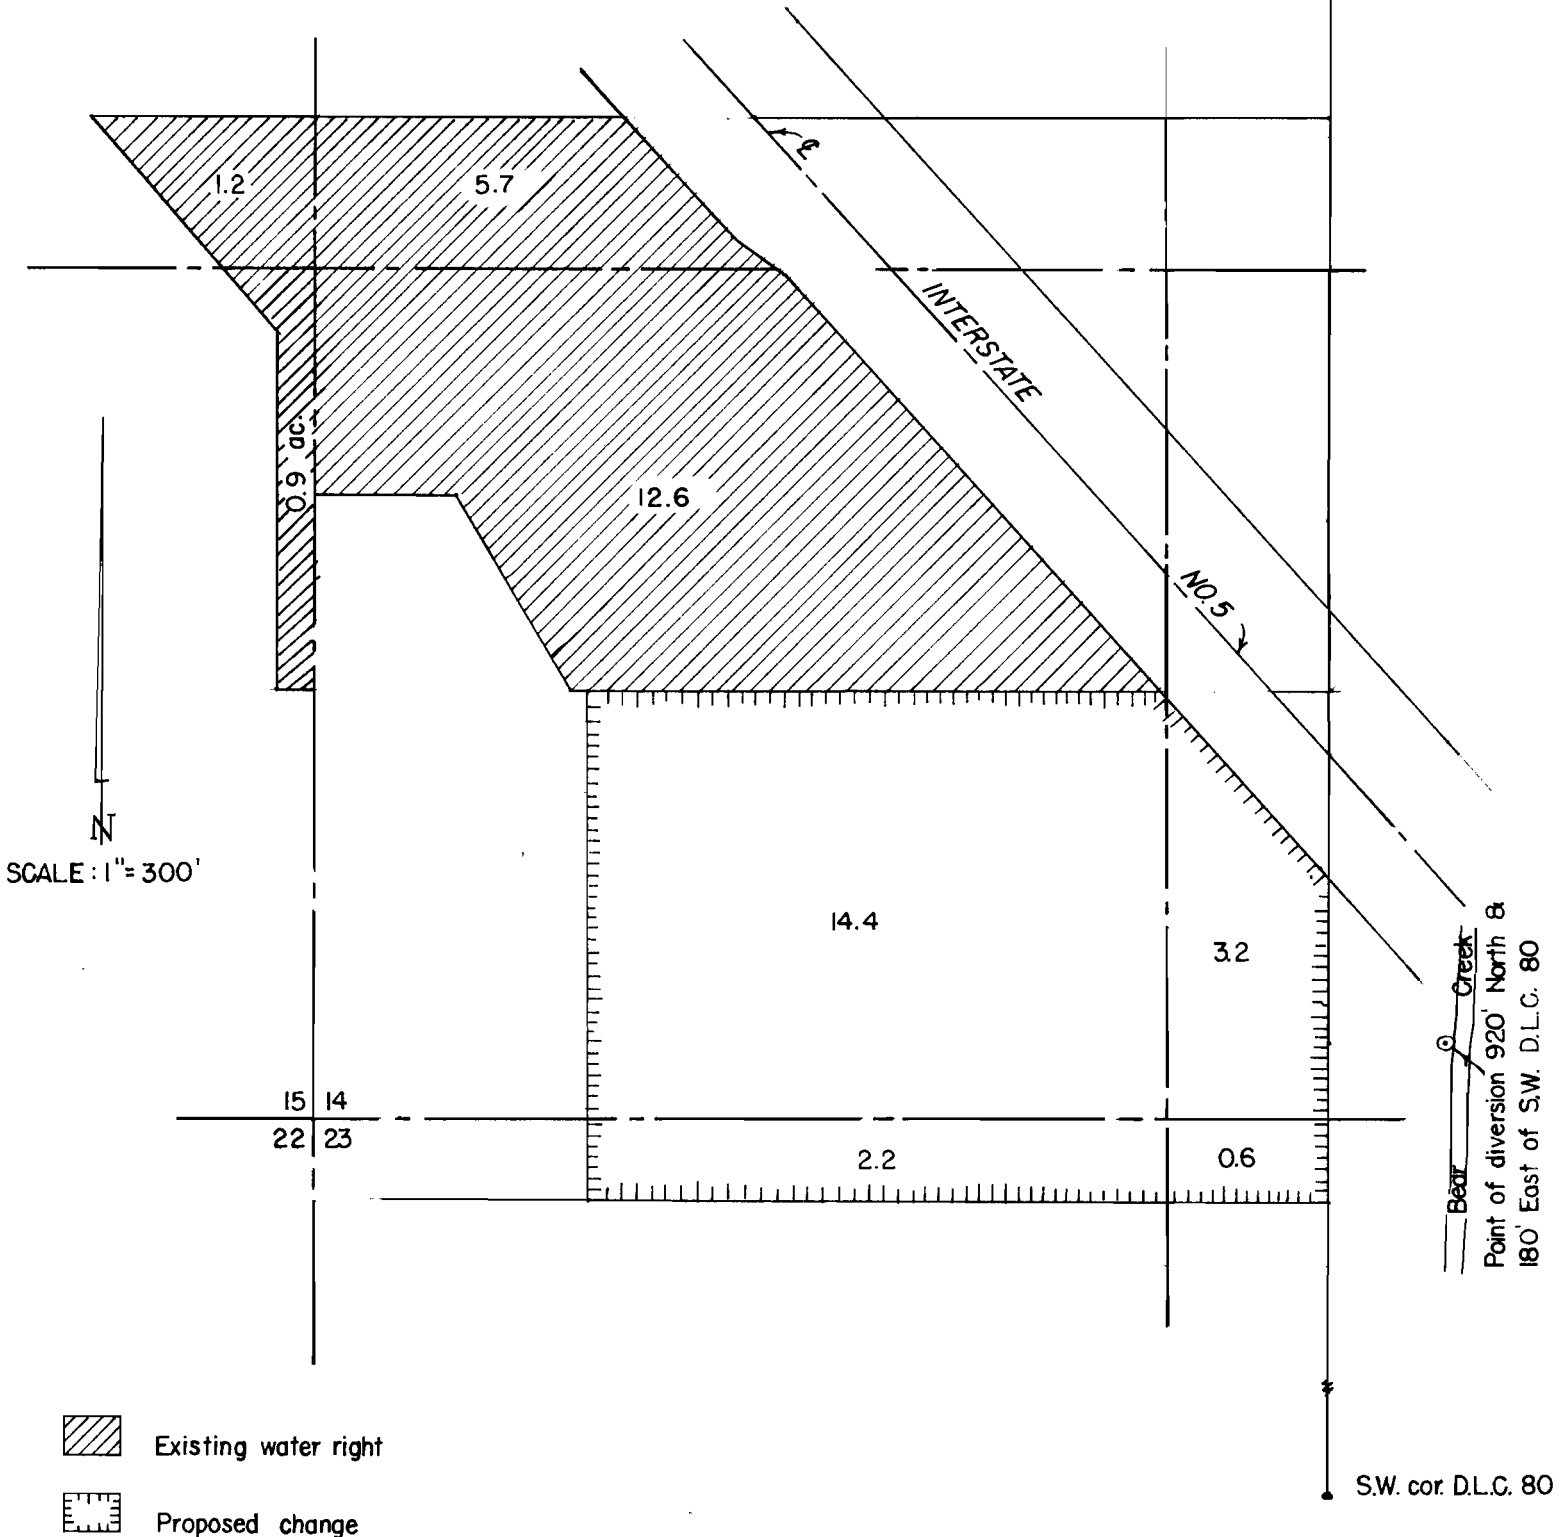

A-130