


T. 38 S. R. 3 W. W. M.

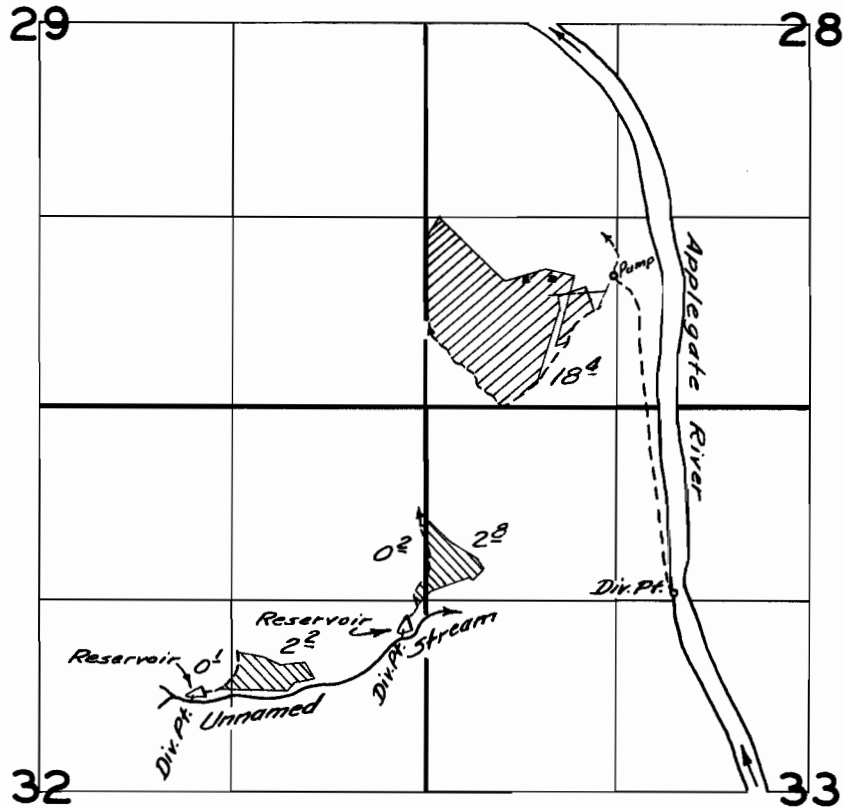

**FINAL PROOF SURVEY**  
UNDER

Application No. <sup>R-27664</sup> 27665... Permit No. <sup>R-1433</sup> 21723...  
IN NAME OF

.....*Marion Dunlap*.....

Surveyed *April 11, 1960*, by *C. O. Baitha*.....