


T.12 S.R.5 W.W.M.

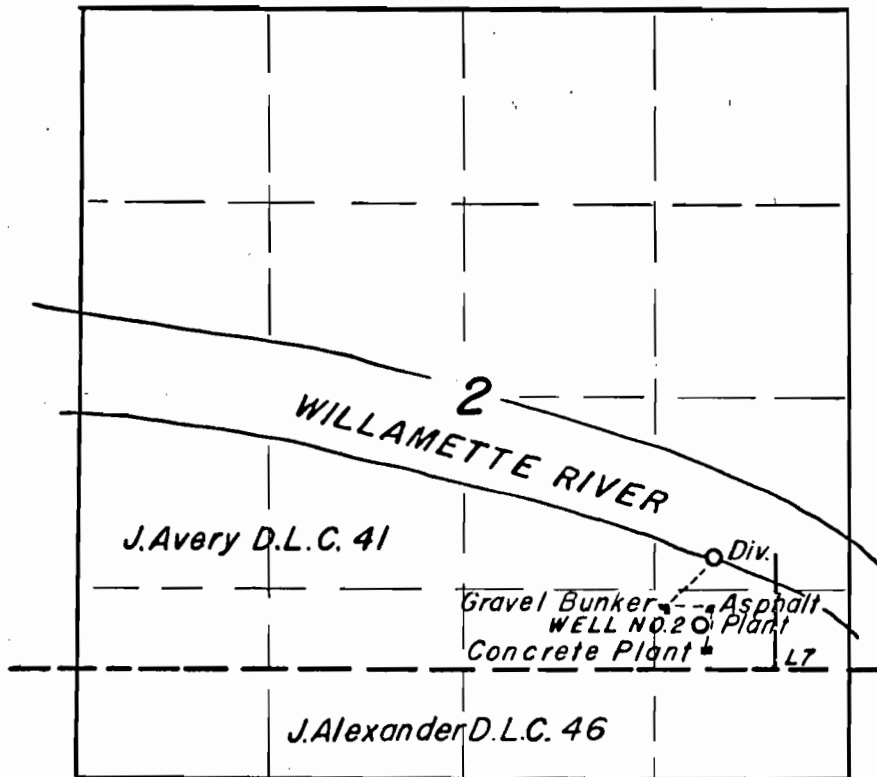

FINAL PROOF SURVEY
UNDER

37461 28169
Application No. G-2253 Permit No. G-2250
IN NAME OF

Corvallis Sand & Gravel Company

Surveyed *Mar. 23 1965*, by *F. Slegmund*..