


T.4S.R.1E.W.M.

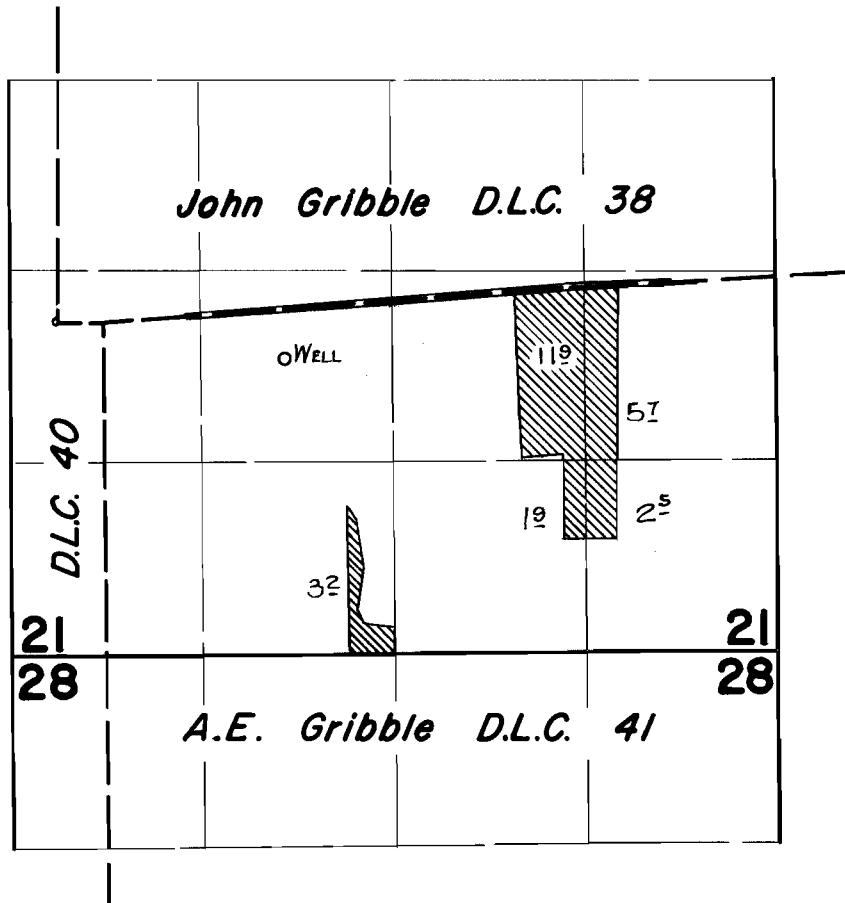

FINAL PROOF SURVEY UNDER

Application No. G-2092 Permit No. G-1960
IN NAME OF

FRANK LAIS

Surveyed April 19 1963, by *R.H. Jackson*