


T.4S. R.1E. W.M.

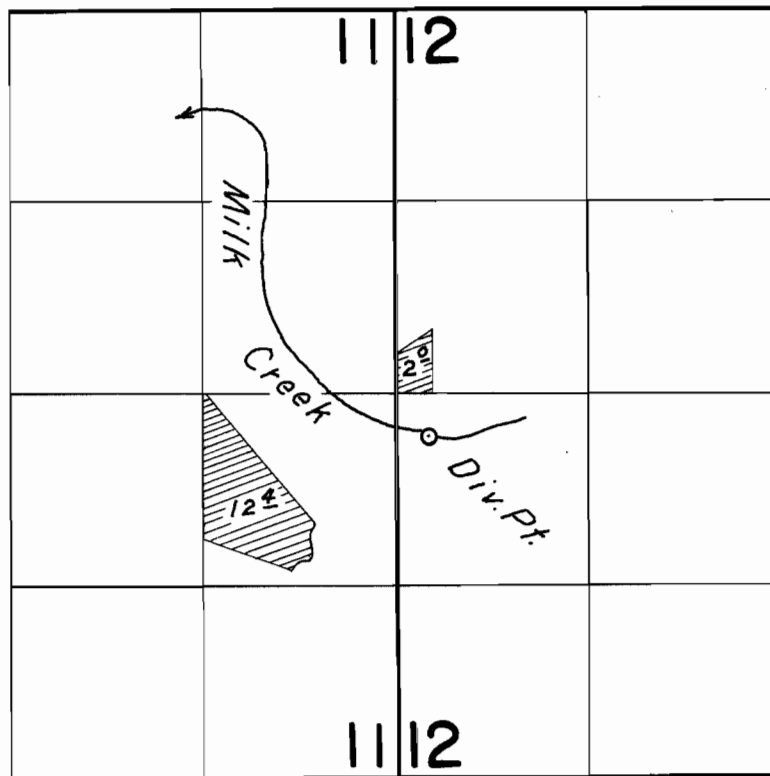

FINAL PROOF SURVEY
UNDER

Application No. 37630 Permit No. 28059
IN NAME OF

HELEN SCALLON

Surveyed July 24, 1964, by C.J. Gardner