


T. 4 N. R. 5 W. W.M.

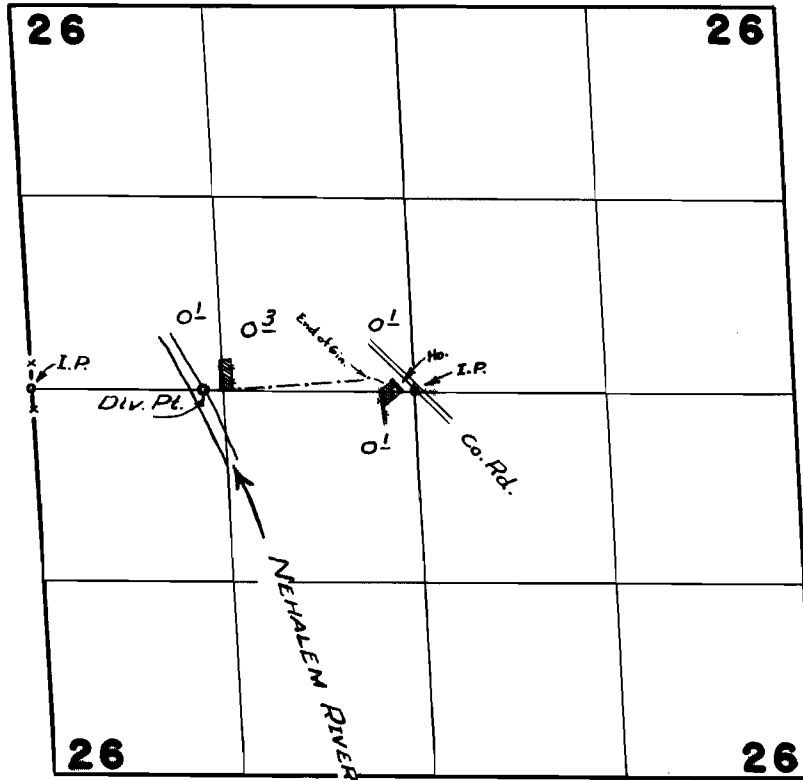

**FINAL PROOF SURVEY**  
UNDER

Application No. 33073 Permit No. 26155  
IN NAME OF

WILLIAM H. GARDNER

Surveyed Aug. 13, 1964, by m. Bish

Note: Sec. layout from Applic. map