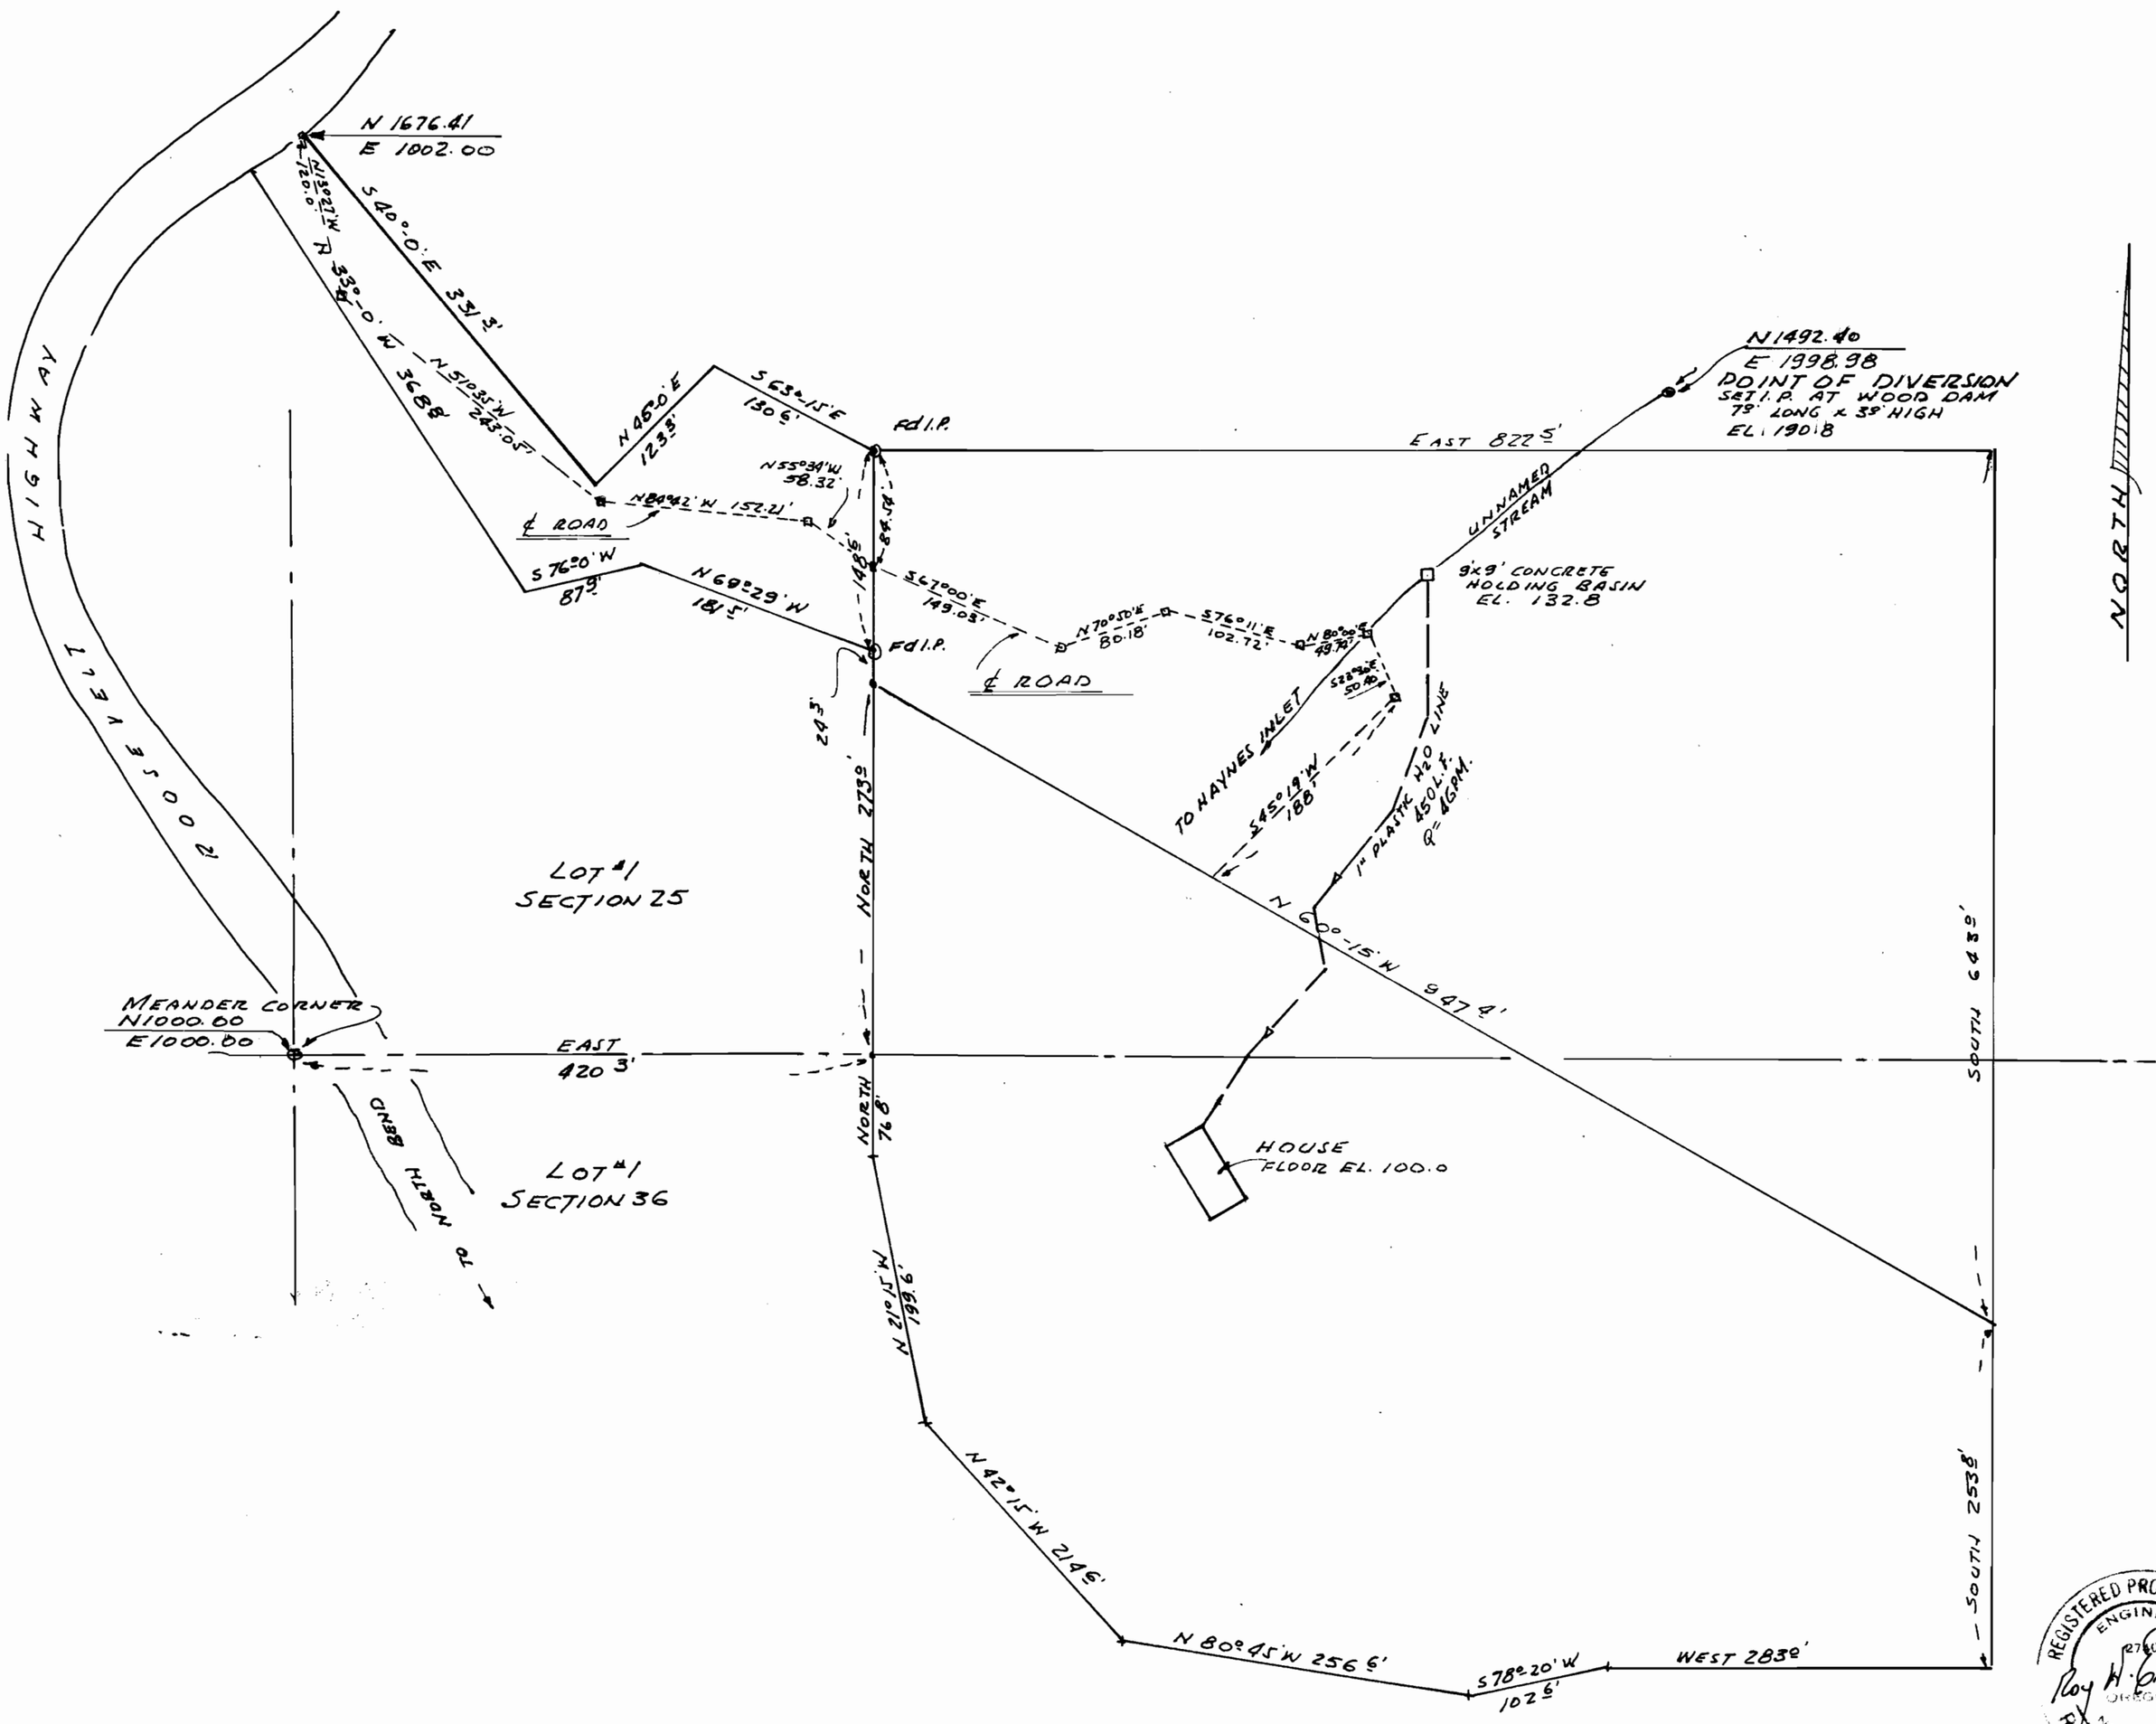

Application No. 33578
Permit No. 26563

REGISTERED PROFESSIONAL ENGINEER
2760
Roy H. Erichsen
OREGON
NOV. 3, 1964
ROY H. ERICHSEN

WATER RIGHTS SURVEY
FOR: HELEN FENLEY, NORTH BEND, OREGON
PORTION OF LOT 1, SECTION 25 AND LOT 1
SECTION 36, TOWNSHIP 24 SOUTH, RANGE
13 W. W. M., COOS COUNTY, OREGON
SCALE: 1" = 100' 12-30-1959
R. H. ERICHSEN & ASSOCIATES
CONSULTING ENGINEERS
5TH & HIGHLAND, COOS BAY, OREGON