


T.28S.R.12W.W.M.

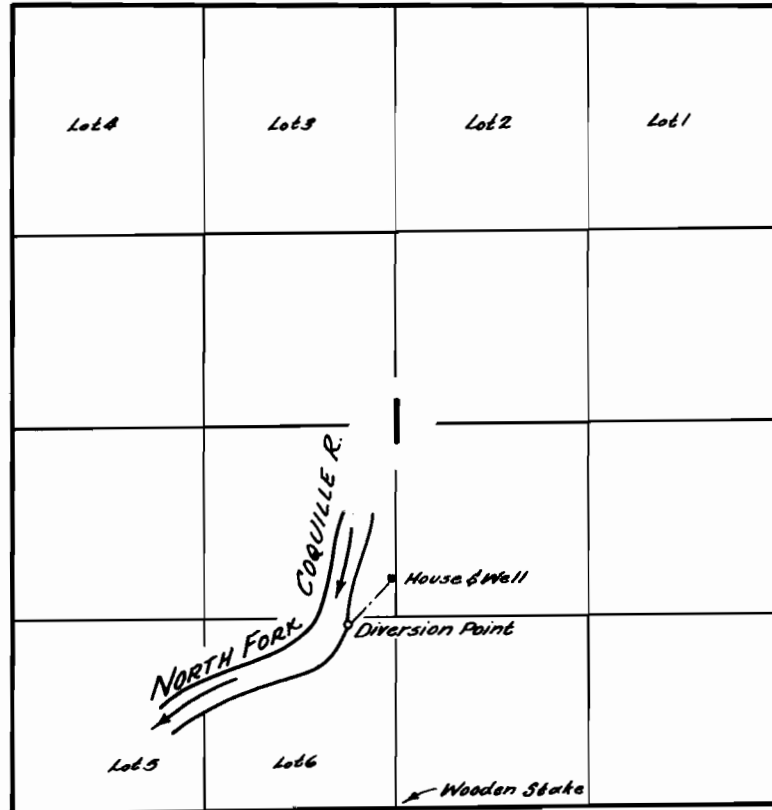

FINAL PROOF SURVEY
UNDER

Application No. 34833 Permit No. 27523
IN NAME OF

Robert W. Mast

Surveyed Aug. 6, 1963, by C. Baker