


18 17  
19 20

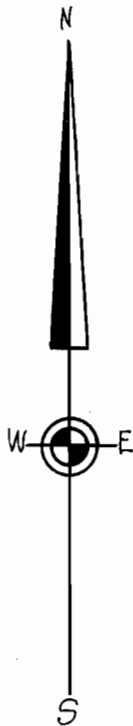

WATER FILING FOR  
ROBT. & BETTY VAN LEER  
IN NW $\frac{1}{4}$  NW $\frac{1}{4}$  SEC. 20, T. 37S., R. 14W.  
WM., CURRY CO., ORE.  
Scale 1 in. = 100 ft. Dec. 1962

1 P. 206 South and 547 East  
of NW Cor. Sec. 20  
T. 37S. R. 14W., WM.

20' Wide dam  
7' deep at front  
timber concrete  
construction

Creek

1 inch pipe line 515' ft



HOUSE

COUNTY ROAD

HUNTER CREEK

REGISTERED  
OREGON  
LAND SURVEYOR

*H. J. Newhouse*

MADE BY  
H. J. Newhouse  
1962

APR

No. 38332  
28535