


T.26S. R.4W.W.M.

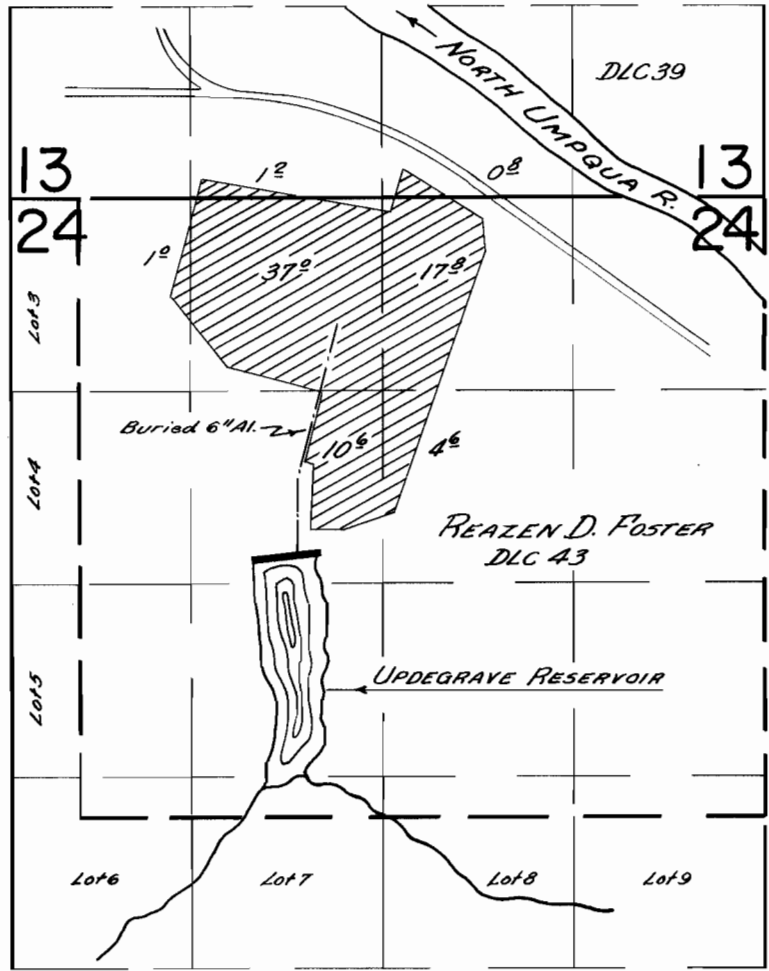

FINAL PROOF SURVEY
UNDER

R-31592 R-2025
Application No. 31593 Permit No. 24921
IN NAME OF

William Updegrave

Surveyed April 1, 1963, by C.O. Bartels