


T. 39S. R. 1E. W. M.

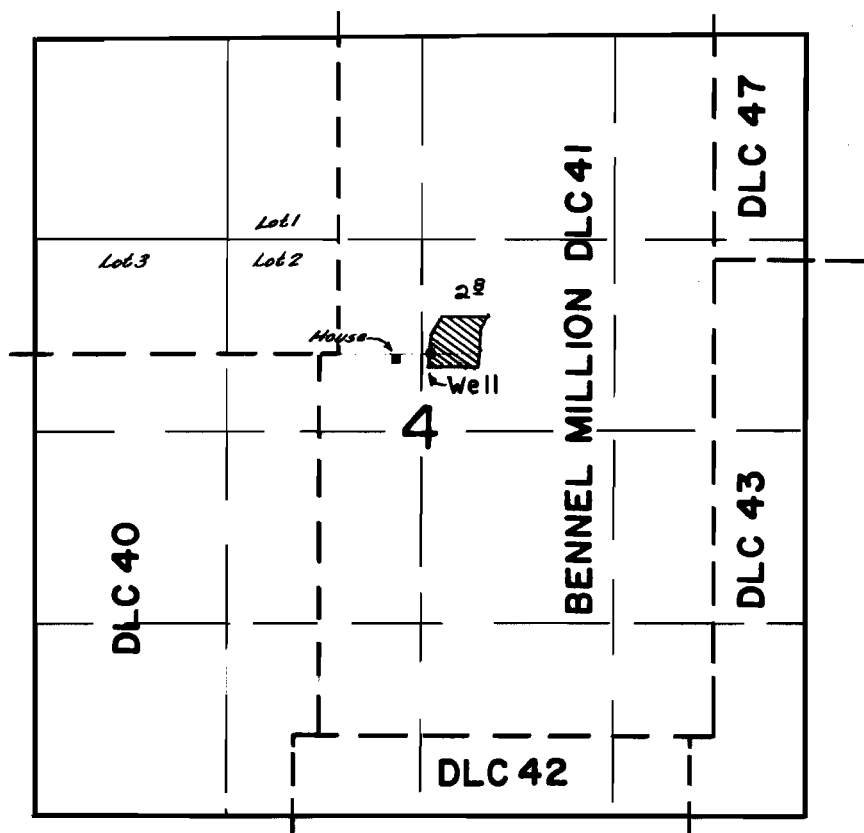

FINAL PROOF SURVEY
UNDER

Application No. G-1449 Permit No. G-1335
IN NAME OF

Francis W & Belle Cox

Surveyed May 14 1963, by G. Baker