


T. 38S. R. 1W. W.M.

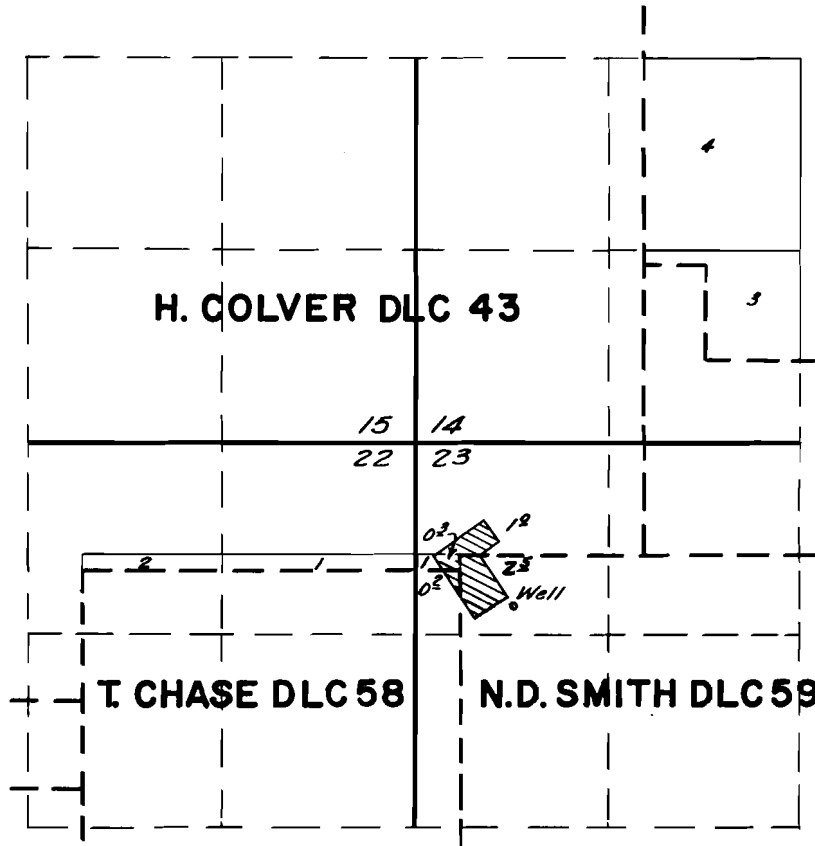

FINAL PROOF SURVEY
UNDER

Application No. G-1992 Permit No. G-1831
IN NAME OF

Jackson County

Surveyed May 17, 1963, by C. Baker