


T. 38S. R. 1 W.W.M.

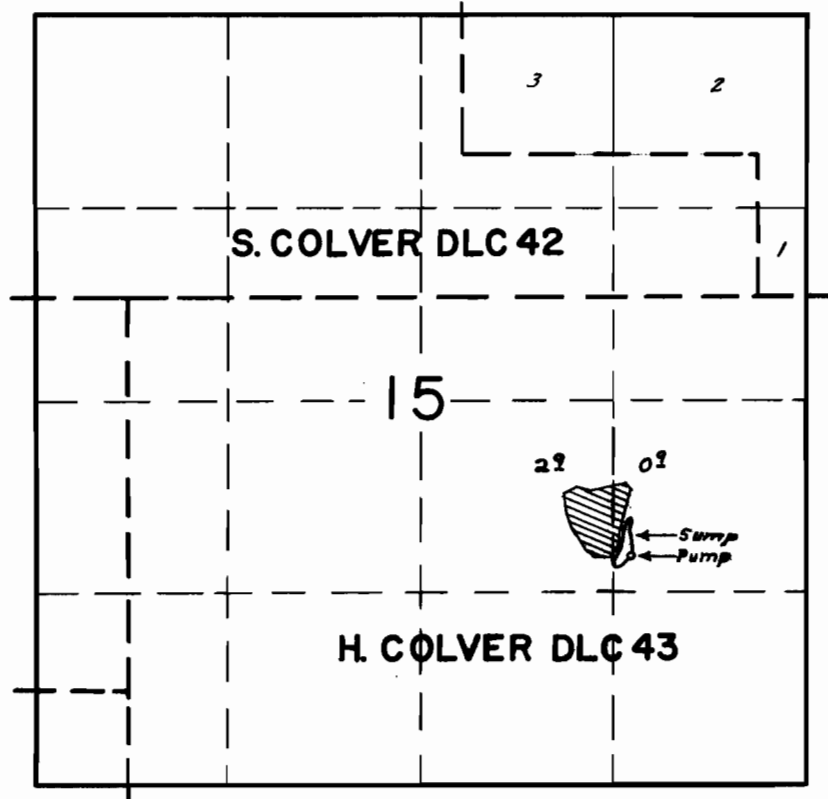

FINAL PROOF SURVEY
UNDER

Application No. G-2281. Permit No. G-2107...
IN NAME OF

..... **Harry and David**

Surveyed May 17, 1963, by C. Baker.....