


T. 38 S. R. 4 E. W. M.

Grizzly Creek - 2 miles

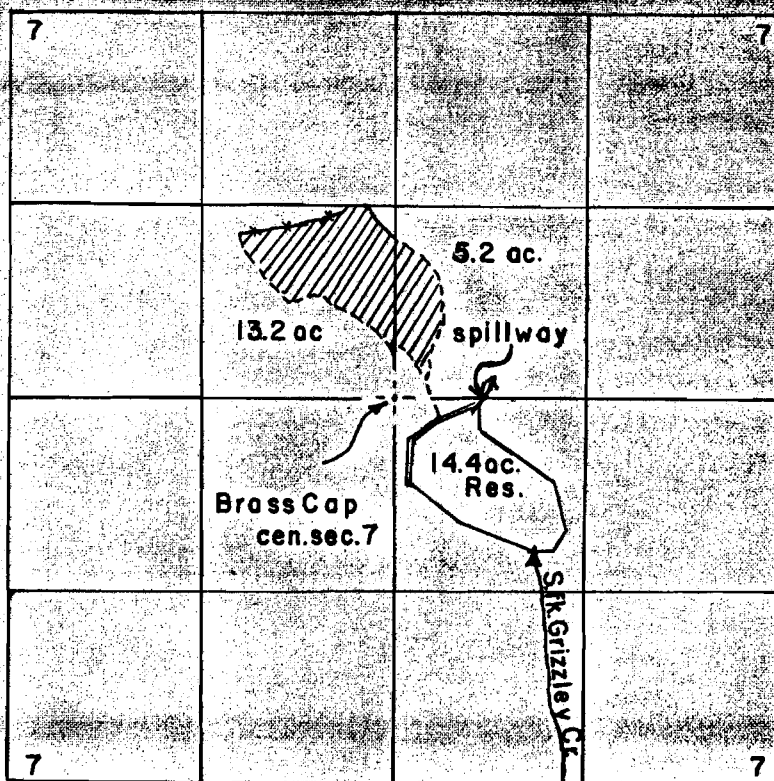

FINAL PROOF SURVEY
UNDER

R-25815 / 6 R-1162
Application No. 25816 Permit No. 20284...
IN NAME OF

Henry A. Owens

Surveyed May 21, 1963, by G.R. Baker