


T. 38 S. R. 4 E. W.M.

Drigly Ck: misc. (1)

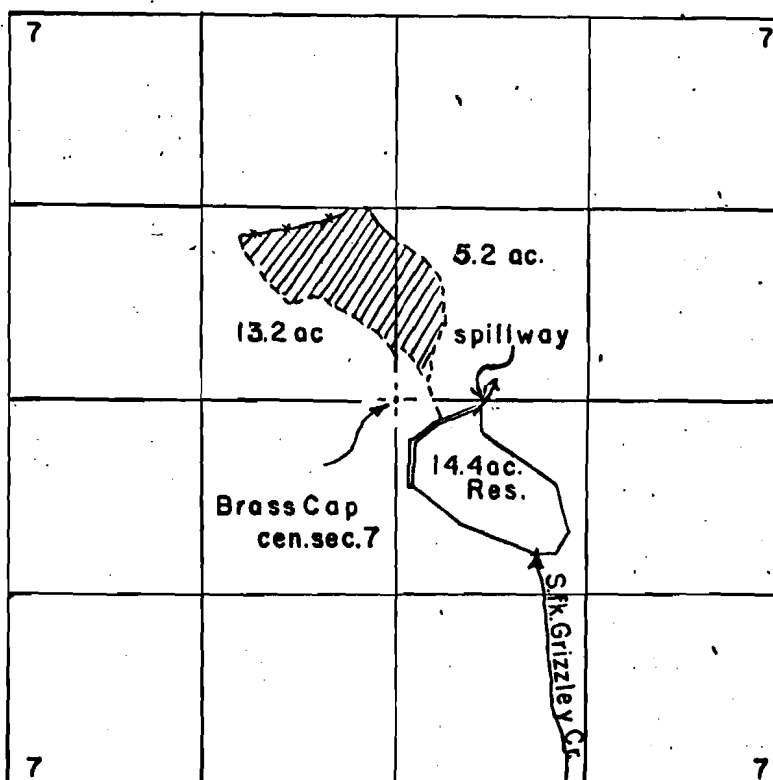

FINAL PROOF SURVEY
UNDER

Application No. R-25815 Permit No. R-1162
IN NAME OF

.....Henry A. Owens.....

Surveyed May 21, 1963, by C.R. Baker.....