


T.37S.R.6W.W.M.

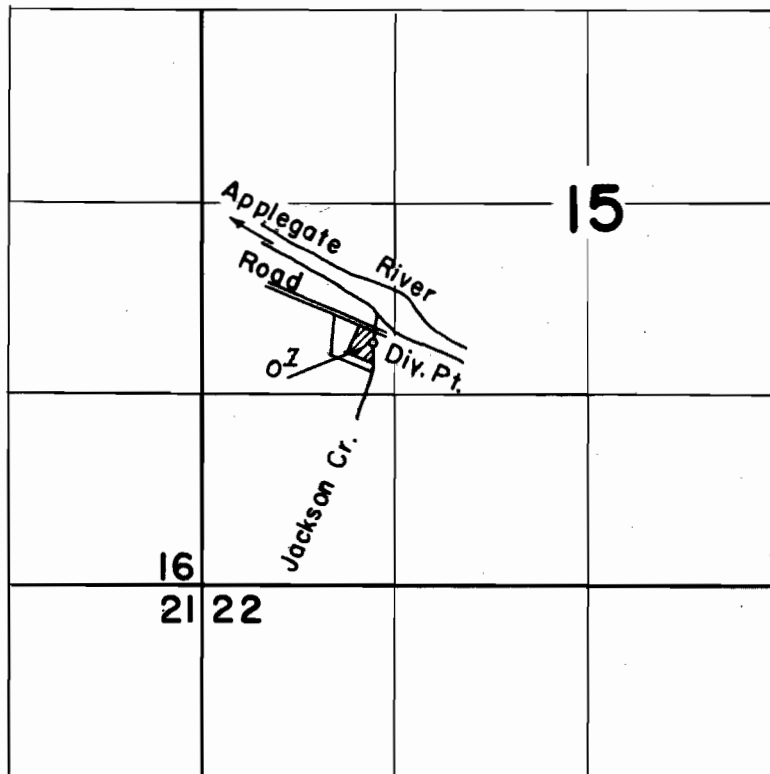

FINAL PROOF SURVEY
UNDER

Application No. 33156... Permit No. 26333...
IN NAME OF

..... **Homer C. Rand**

Surveyed July 9... 1963, by R.H. Jackson.....