


T.39 S. R.8 W.W.M.

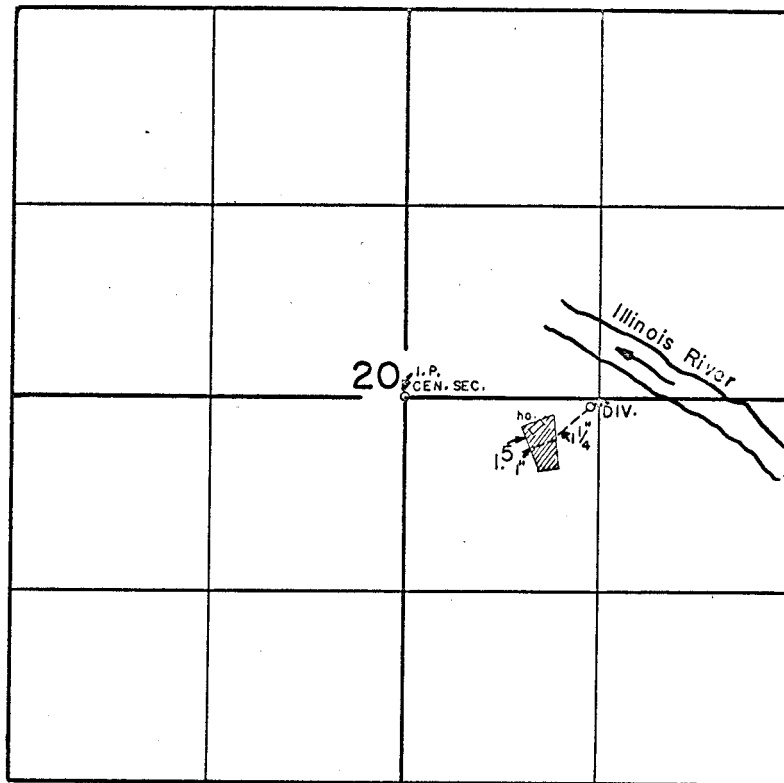

FINAL PROOF SURVEY
UNDER

Application No. 37039 Permit No. 27647
IN NAME OF

JOHN M. McGEE

Surveyed MAY 20 1964, by STEIMER