


T. 18 S., R. 11 W. W.M.

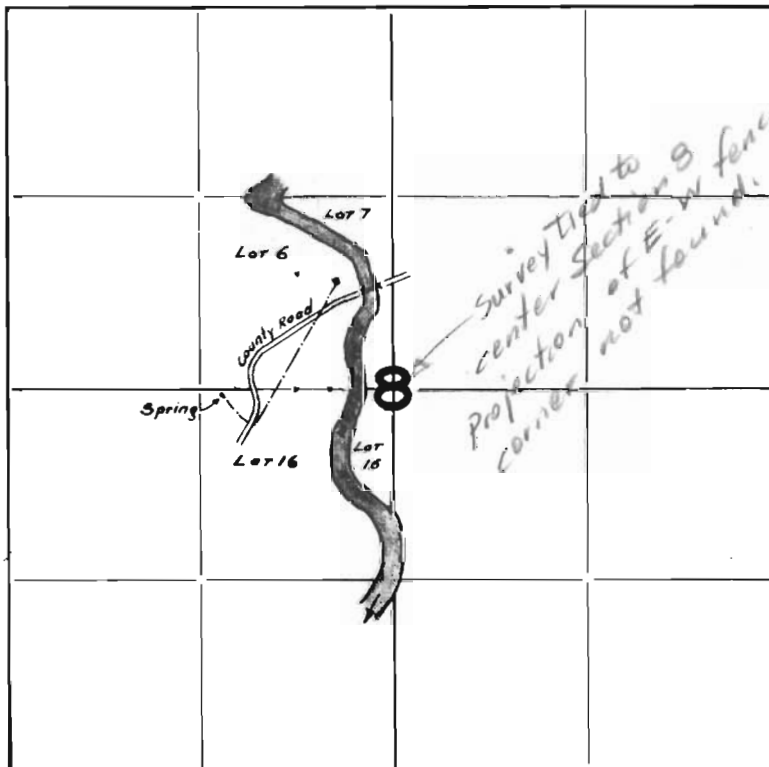

FINAL PROOF SURVEY

UNDIER

Application No. 19593 Permit No. 15180

IN NAME OF

Theodore Reese

Surveyed Aug. 11, 1943, by Geo. W. Aderman