
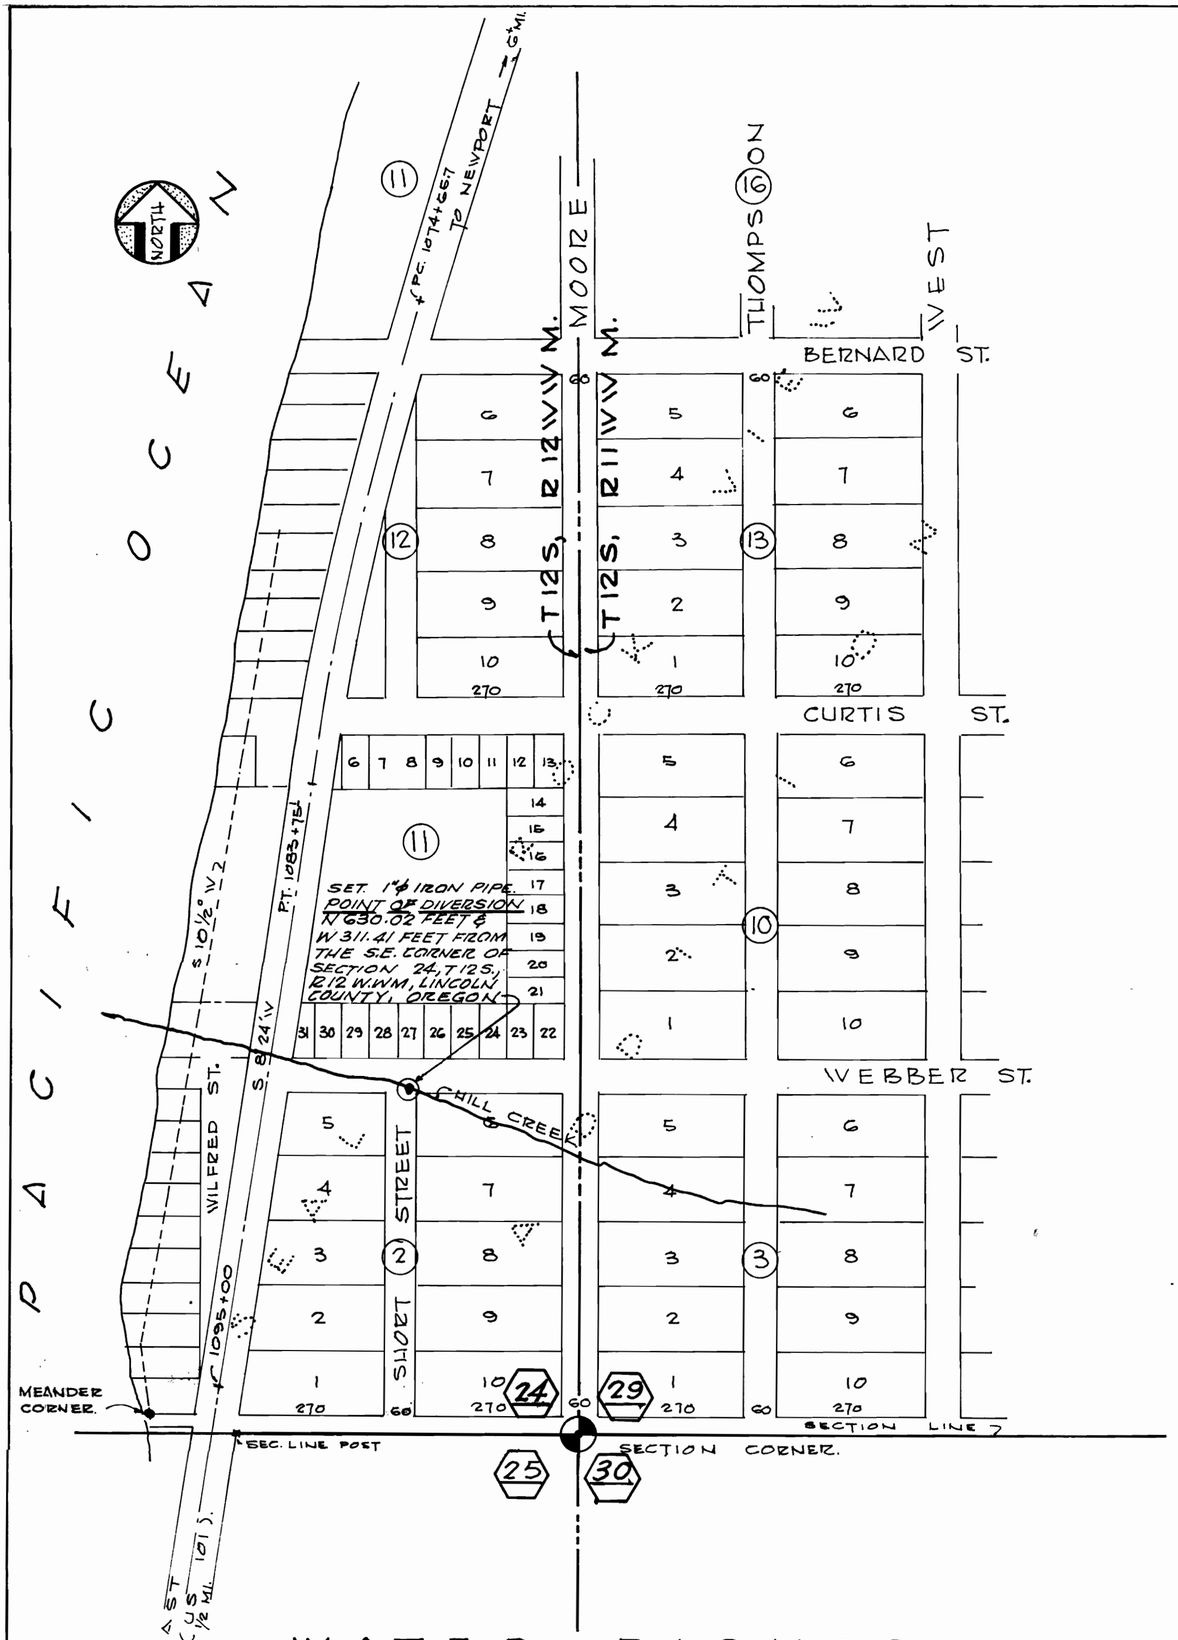


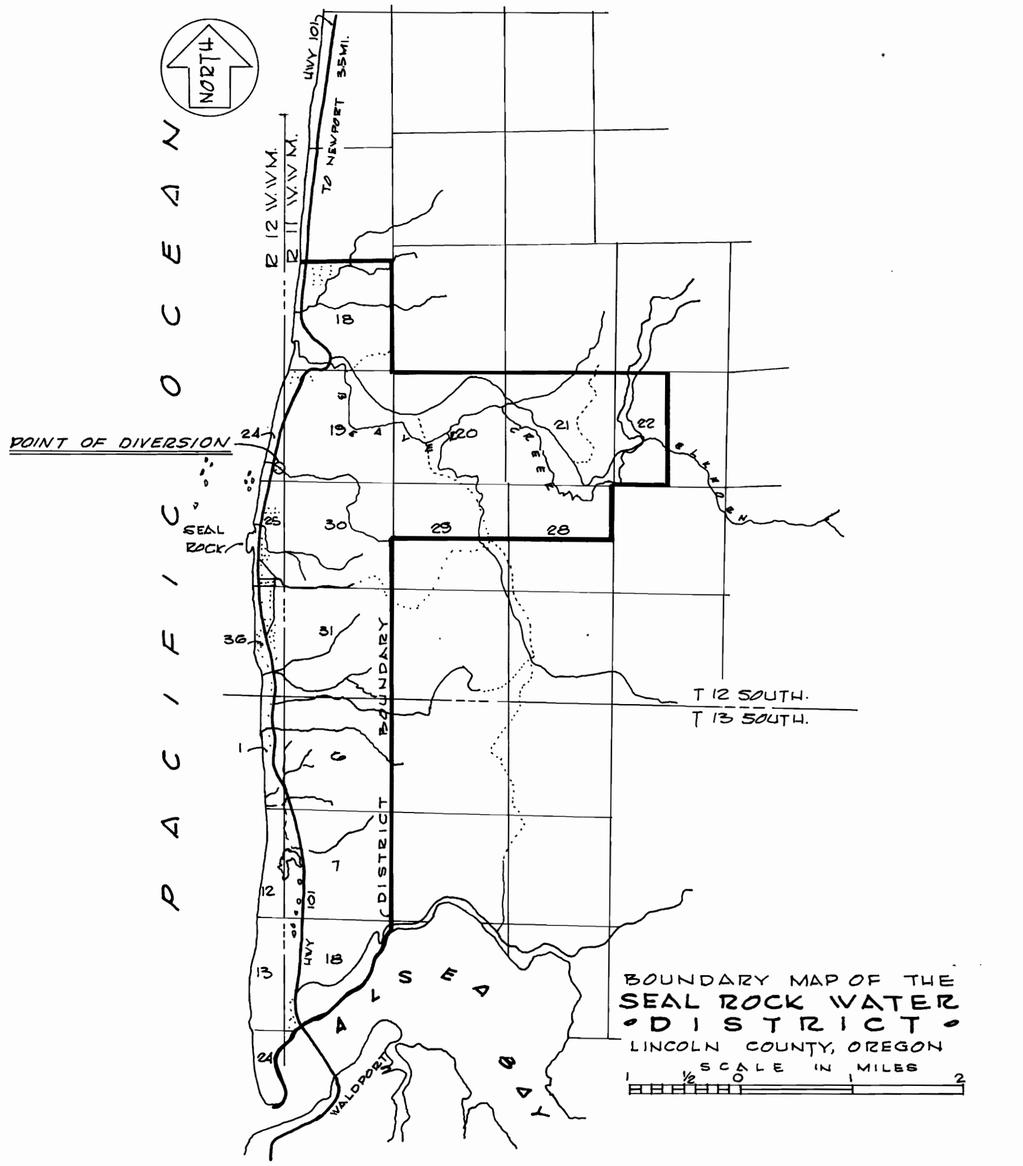

Application No. 33398
Permit No. 26489

WATER RIGHTS SURVEY

SEAL ROCK VIEW ADDITION - SECTION 24, T 12 SOUTH, R 12 WEST W.M. LINCOLN COUNTY, OREGON.

SCALE 1" = 200'

Edward W. Riley

WATER RIGHTS MAP

FOR THE

SEAL ROCK WATER DISTRICT - SEAL ROCK, OREGON

SEAL ROCK VIEW ADDITION, SE¼, SE¼, SECTION 24, TOWNSHIP 12 SOUTH, RANGE 12 WEST W.M. LINCOLN COUNTY, OREGON

APPLICATION NO 33398

SCALE: AS NOTED.

JANUARY 25, 1960.

R.H. ERICHSEN & ASSOCIATES - CONSULTING ENGINEERS
COOS BAY, OREGON.