


T. 7 S. R. 1 W. W. M.

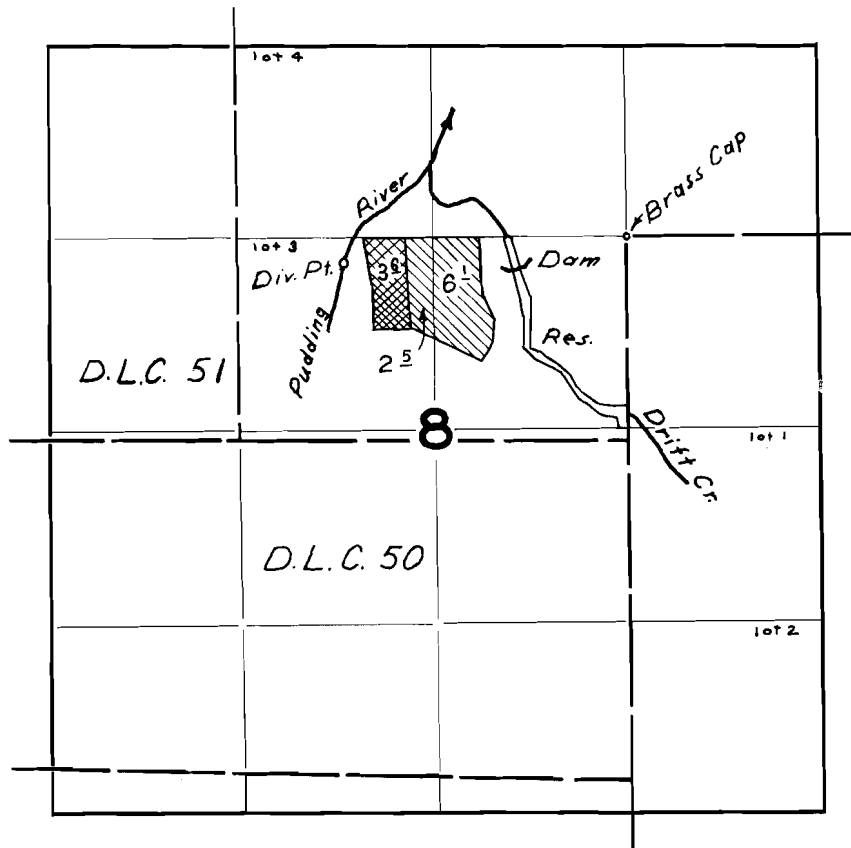

32660 - Primary from Pudding River



37259 - Supplemental from Drift Cr. Res.

FINAL PROOF SURVEY UNDER

Application No. 32660 Permit No. 25755
37259 27758
R-37258 R-2708


IN NAME OF





CARL A. SCHMID

Surveyed MAY 21 1964, by F. L. SIEGMUND

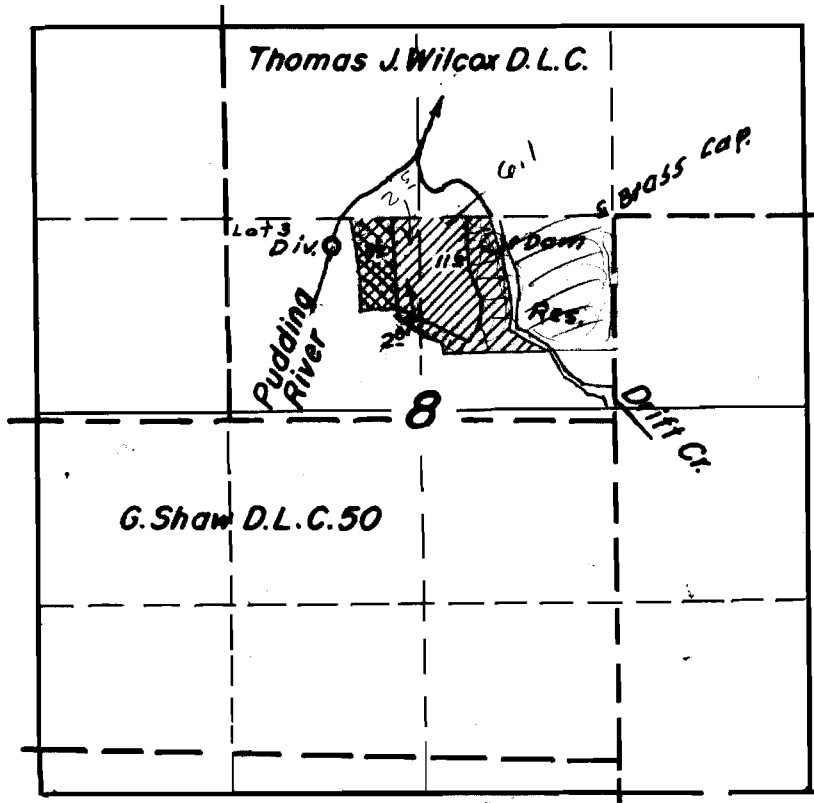T.7S. R.1W.W.M.

Superseded



| | | | |
|-------------------------------------------------------------------------------------|----------------|--------------------------------------------------------------------------------------|---------|
|  | Sum Area Res. |  | 37259 |
|  | 32660 Perm for |  | 32660 ✓ |

FINAL PROOF SURVEY
UNDER

| | | |
|-----------------|---------|------------------|
| | 37259 | 27758 |
| | R 37258 | R 2708 |
| Application No. | 32660 | Permit No. 25755 |

IN NAME OF

Carl Schmid

Surveyed *May 21* 1964, by *Floyd L. Sigmund*