


T.6 S.R.4 W.W.M.

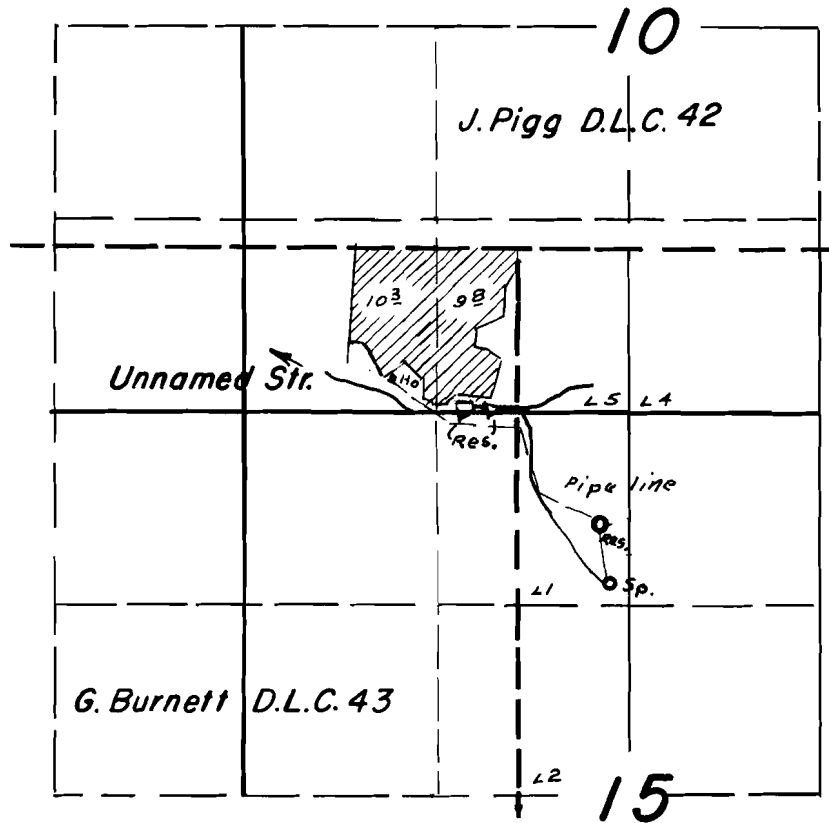

FINAL PROOF SURVEY
UNDER

Application No. R-33371 33372 Permit No. R-2277 26379
IN NAME OF

Harry Tombleson

Surveyed Nov. 12 1963, by F. Siegmund