


# T. 1 S. R. 9 W.W.M.

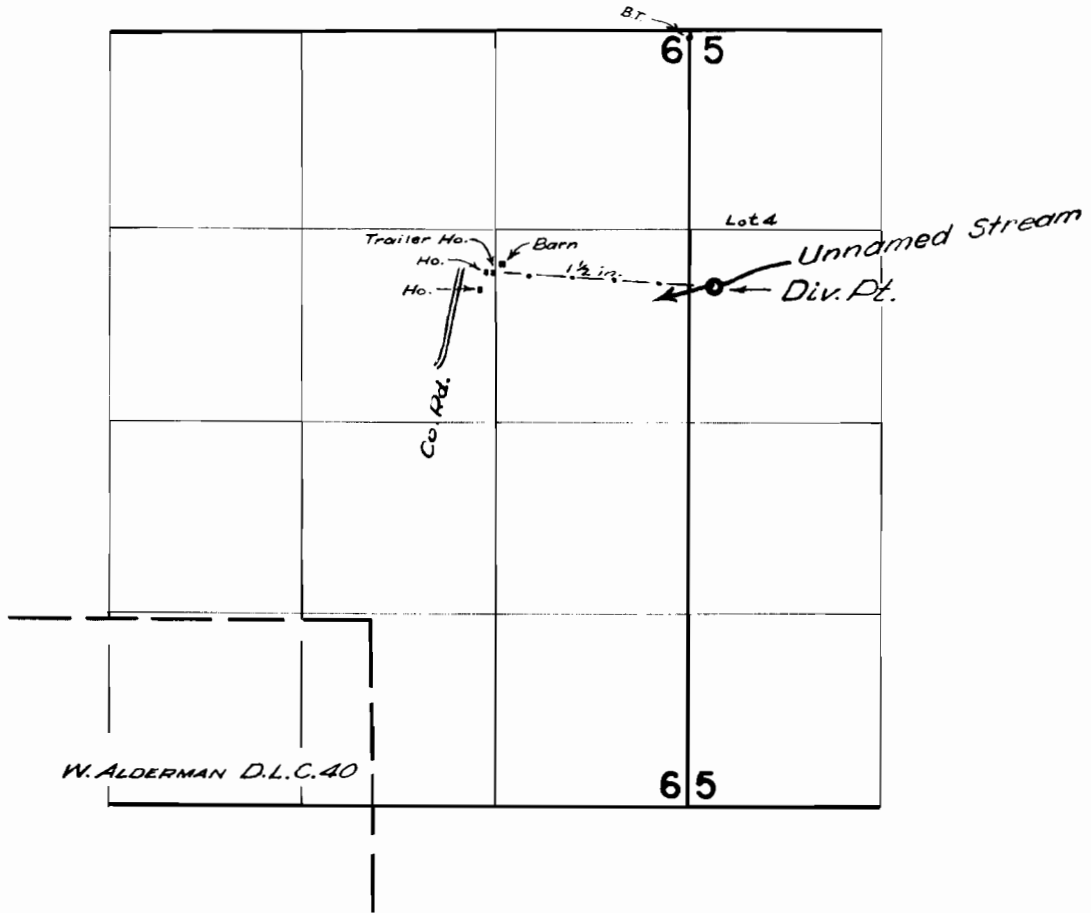

## FINAL PROOF SURVEY UNDER

Application No. 37008 Permit No. 27644  
IN NAME OF

*EDWIN C. & ELIZABETH B. LANDIS*

Surveyed *AUG. 1* 1963, by *C. BAKER*