

WATER RIGHT SURVEY
FOR

TONY DWARTE & ELMER EASOM

IN SECTION 24, T. 3 N., R. 10 W., W. M.

Scale: 1" = 200 Ft.

Dec. 13, 1961

I certify that this map was
made from the notes of a
survey by me in Dec., 1961



RECEIVED


JAN - 8 1962

STATE ENGINEER
SALEM, OREGON

RECEIVED

JAN 24 1962

STATE ENGINEER
SALEM, OREGON

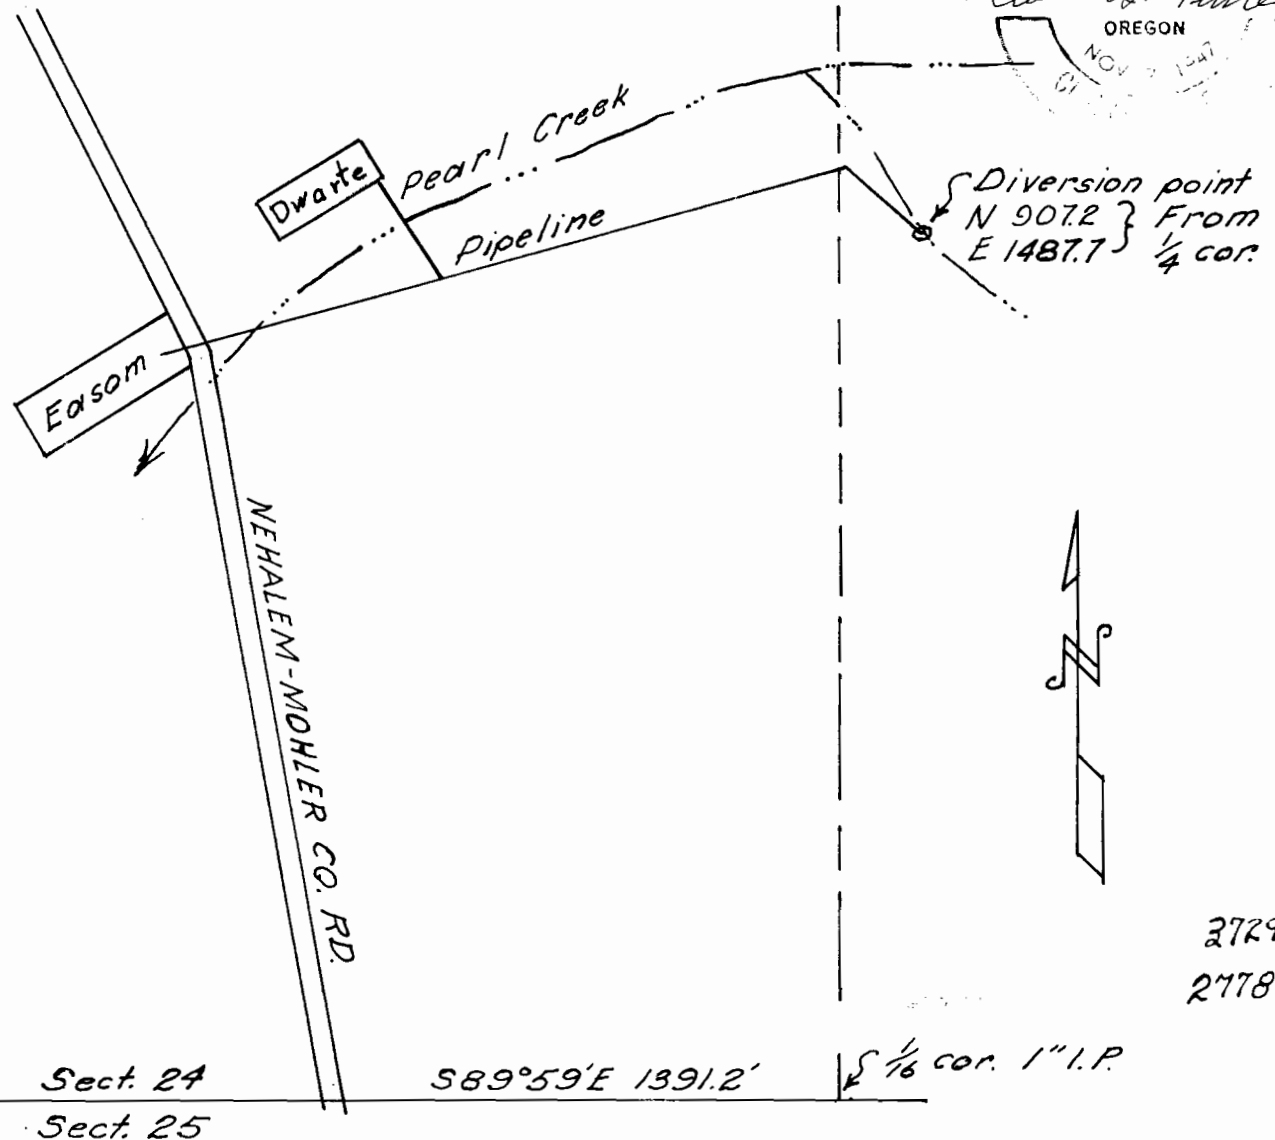

27292

27789