


T. 3 S. R. 2 W. W. M.

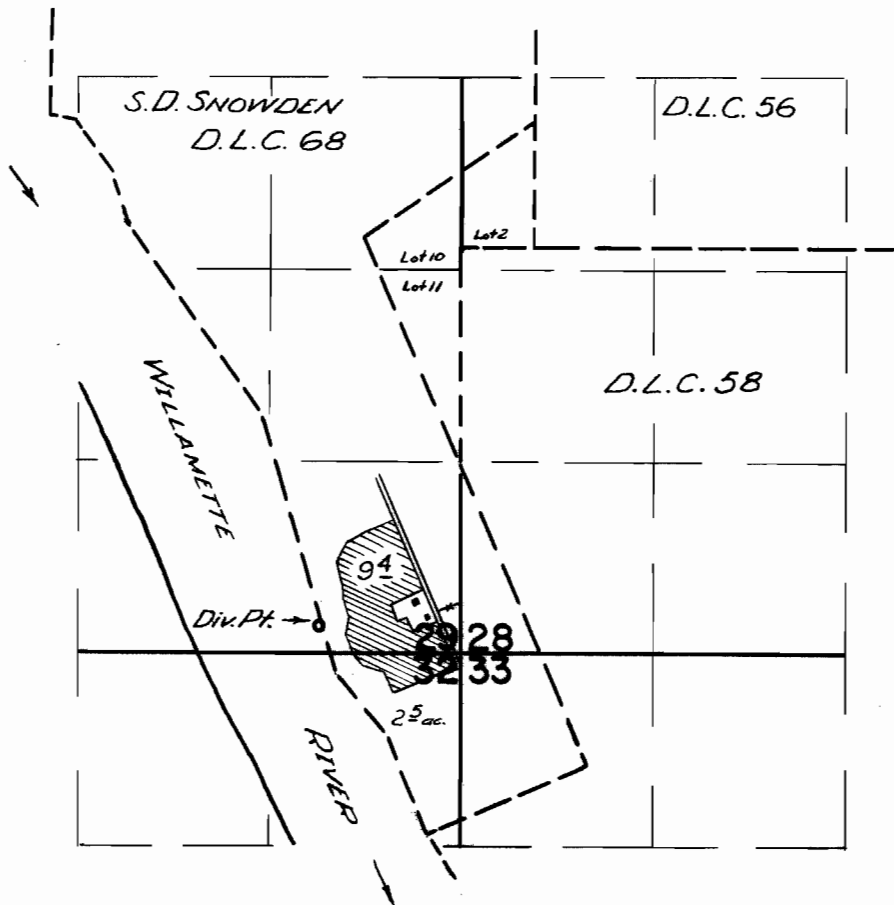

FINAL PROOF SURVEY UNDER

Application No. 33047 Permit No. 26138
IN NAME OF

HOMER BELL

Surveyed April 10, 1963, by F. Bish