




FINAL PROOF SURVEY FOR BIG CREEK DITCH CO. LANDS

UNDER
APPLICATION NO. 6521 6175 PERMIT NO. 4082 3852

SURVEYED OCT. 9-11, 1956 BY M. Bish

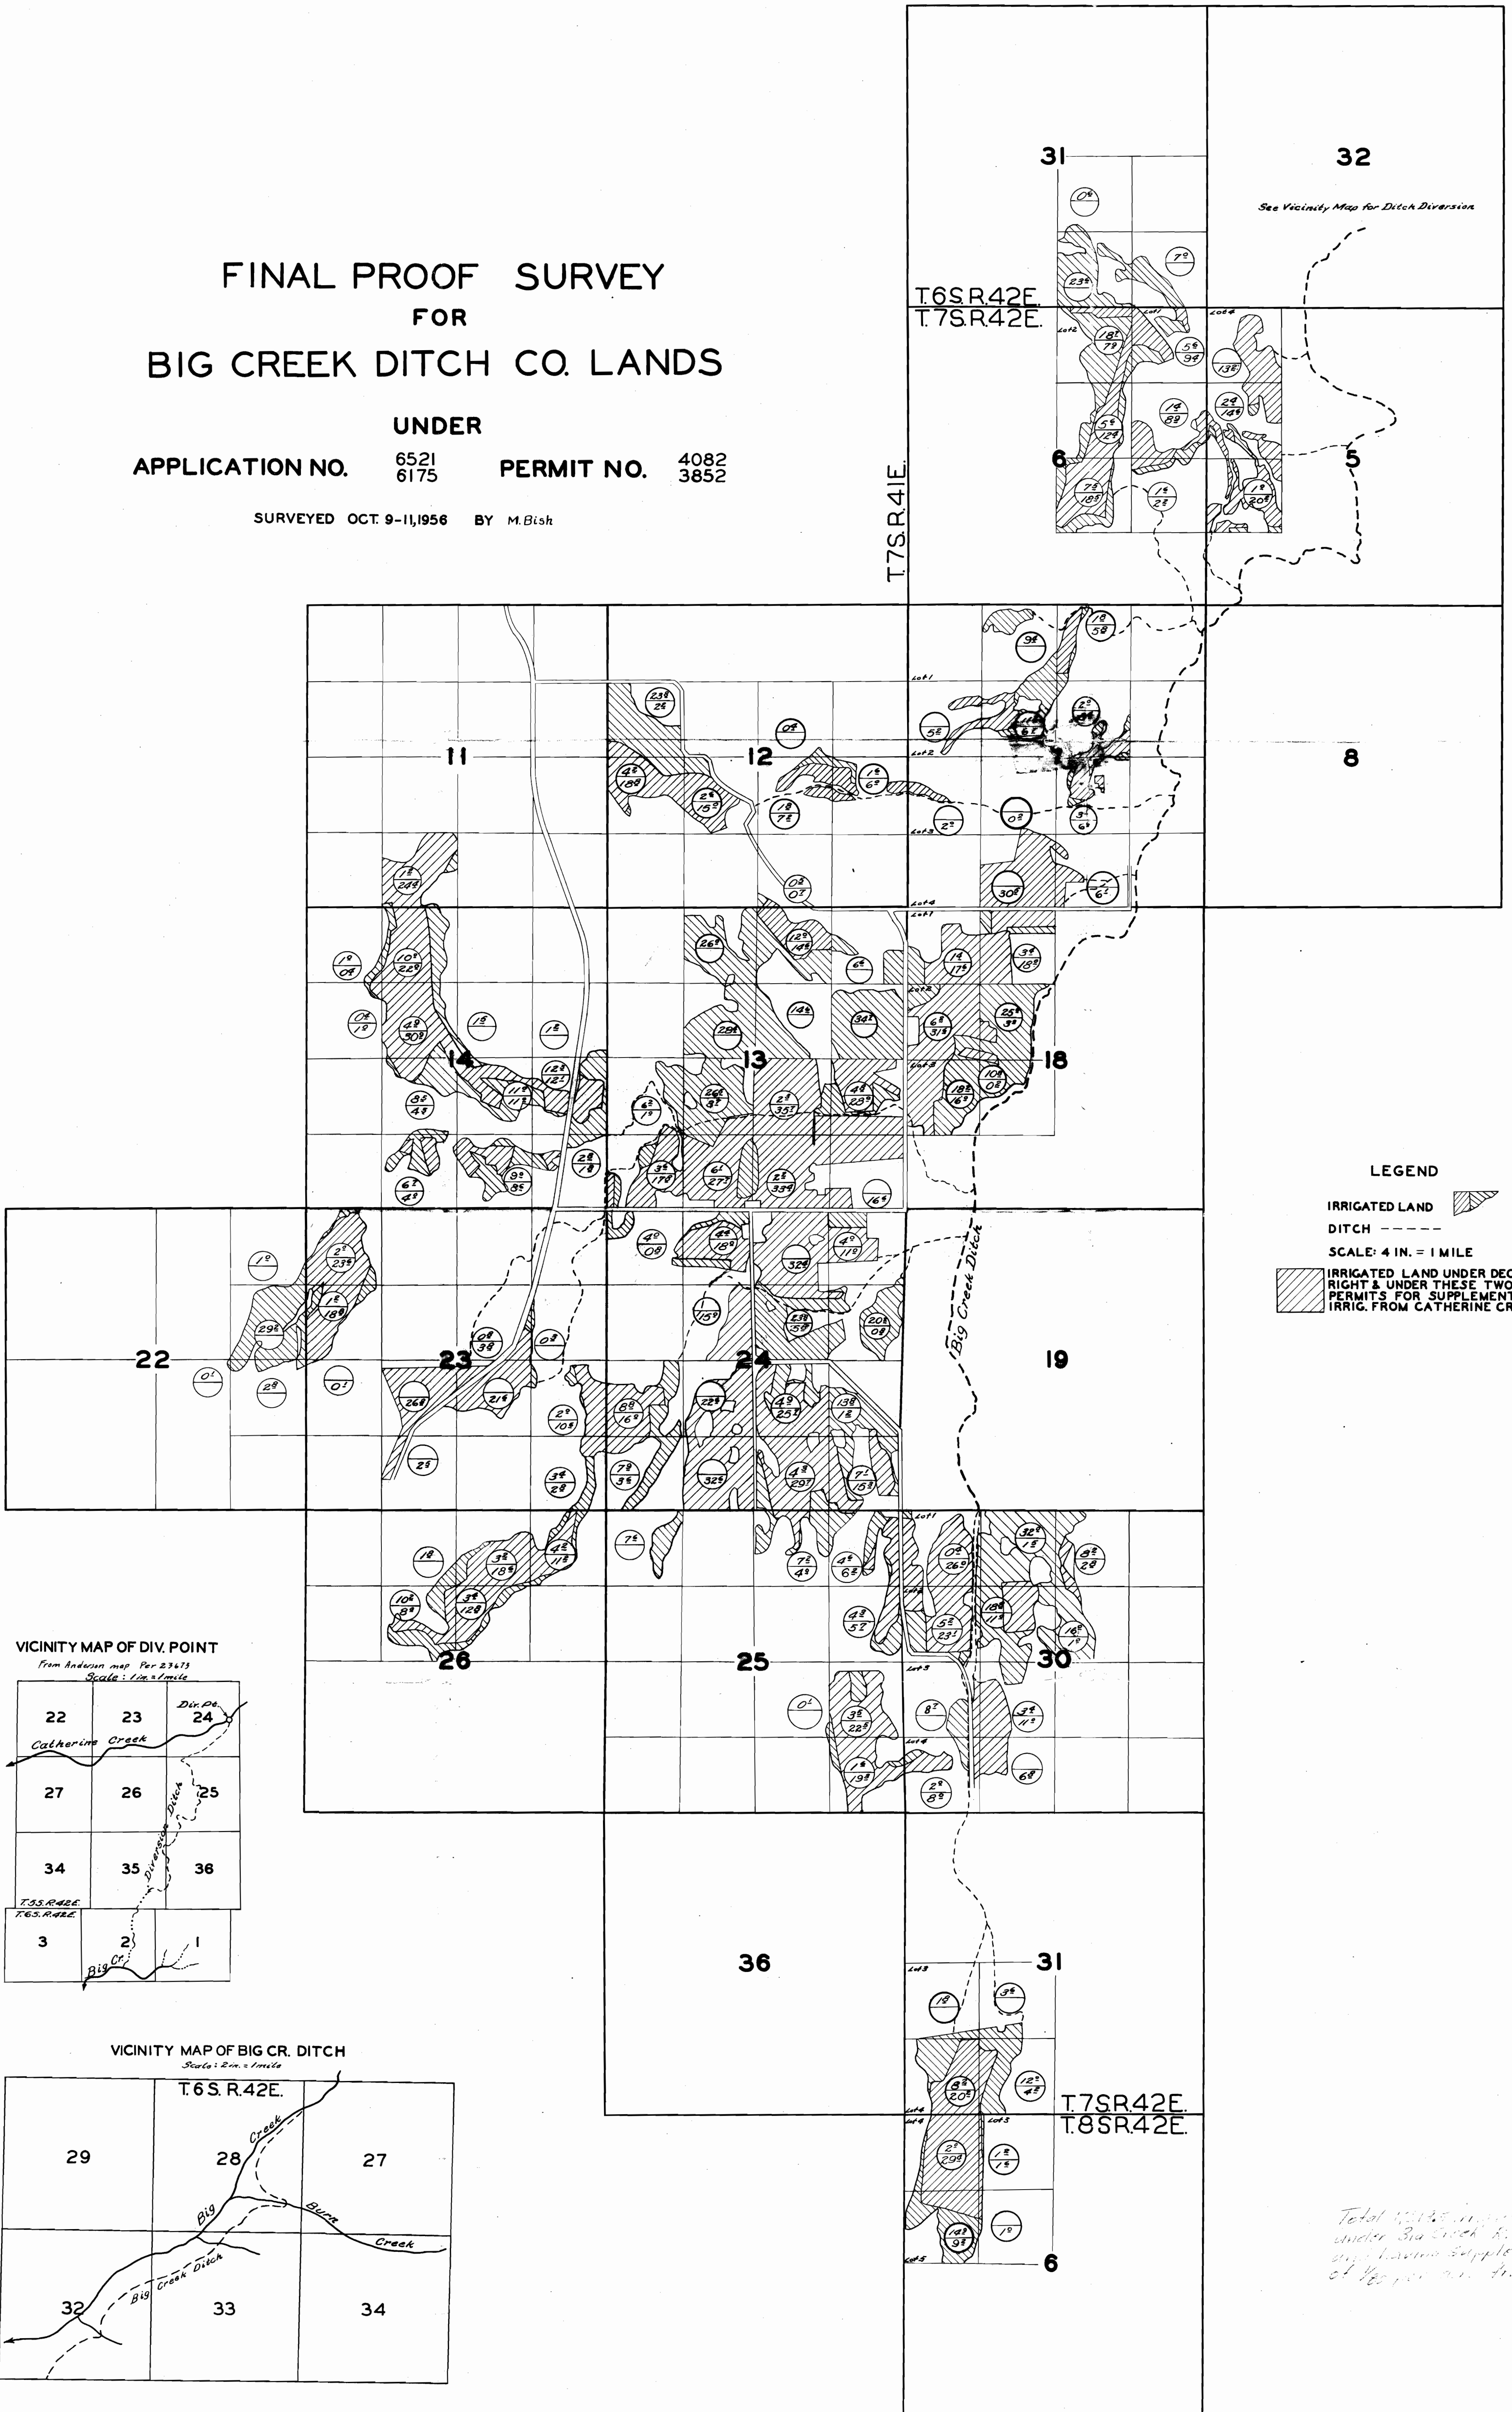

LEGEND
 IRRIGATED LAND
 DITCH - - - - -
 SCALE: 4 IN. = 1 MILE
 IRRIGATED LAND UNDER DECREED RIGHT & UNDER THESE TWO PERMITS FOR SUPPLEMENTAL IRRIG. FROM CATHERINE CREEK

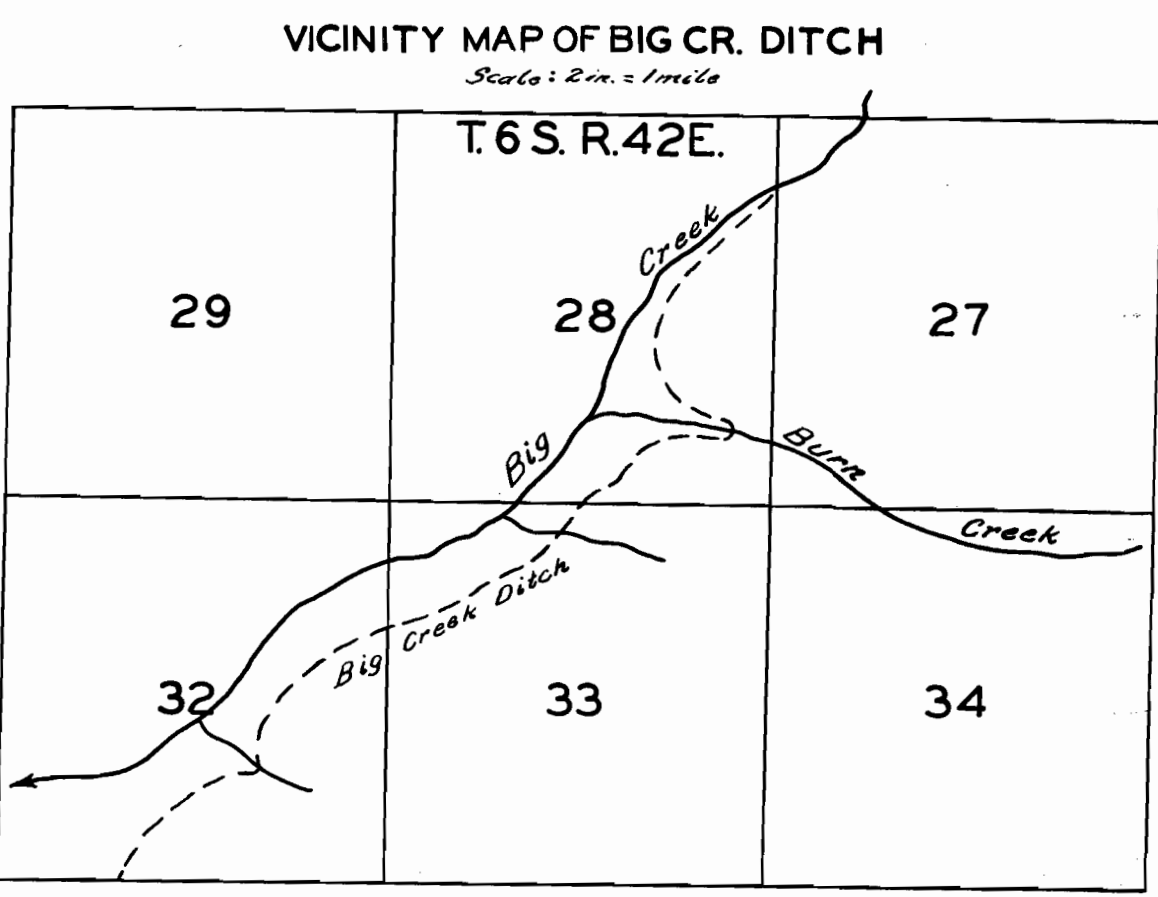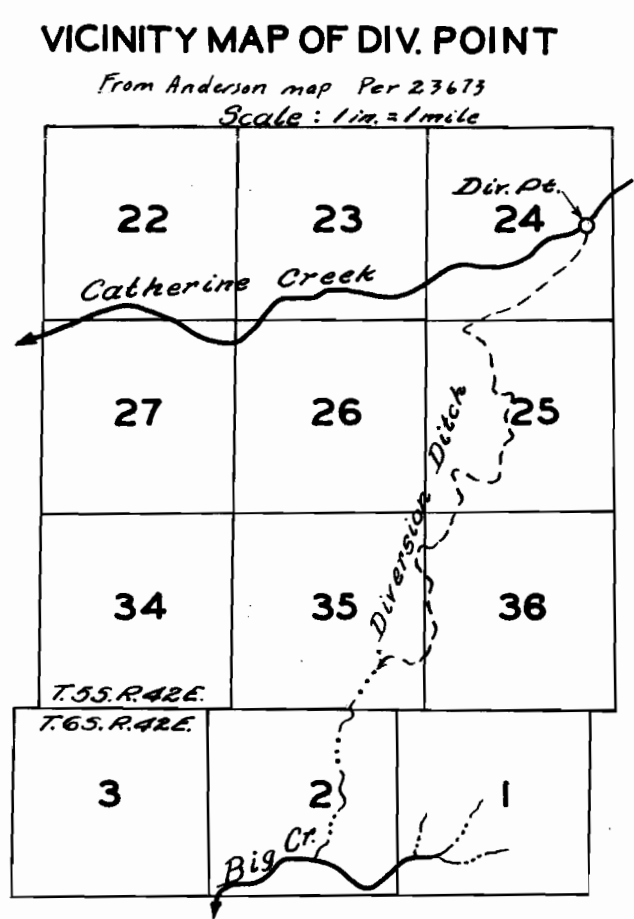

Total 12,125 acres under Big Creek Right and having Supplemental of 485,000 cu. ft. per acre