


T.I.S.R. 5W.W.M.

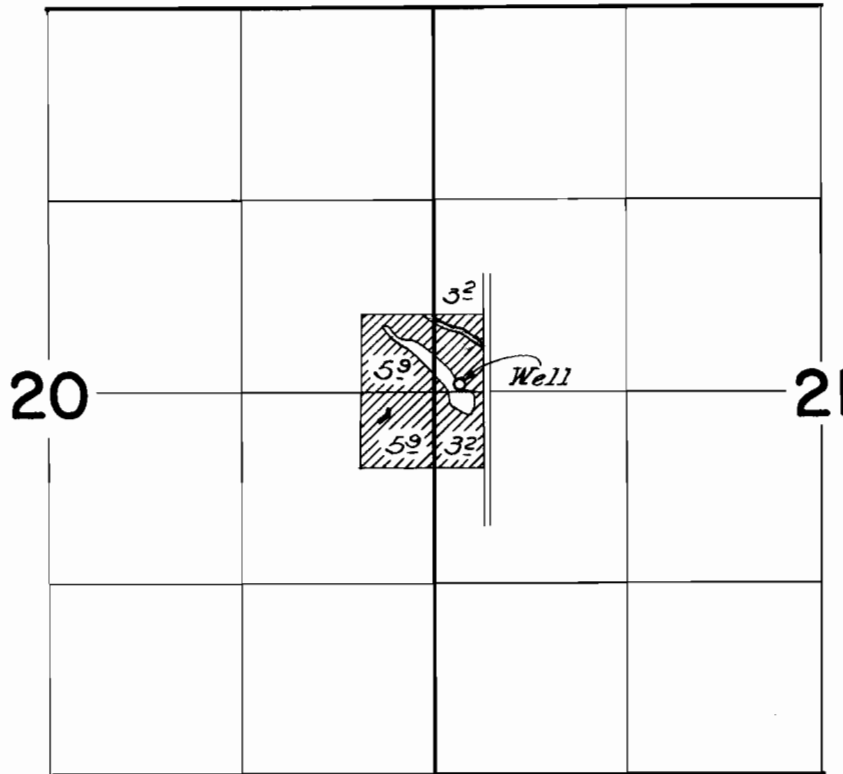

FINAL PROOF SURVEY
UNDER

Application No. G-2396 Permit No. G-2209
IN NAME OF

NORMAN WELCH

Surveyed April 20 1963, by C. Baker