


# T.12S.R.5 W.W.M.

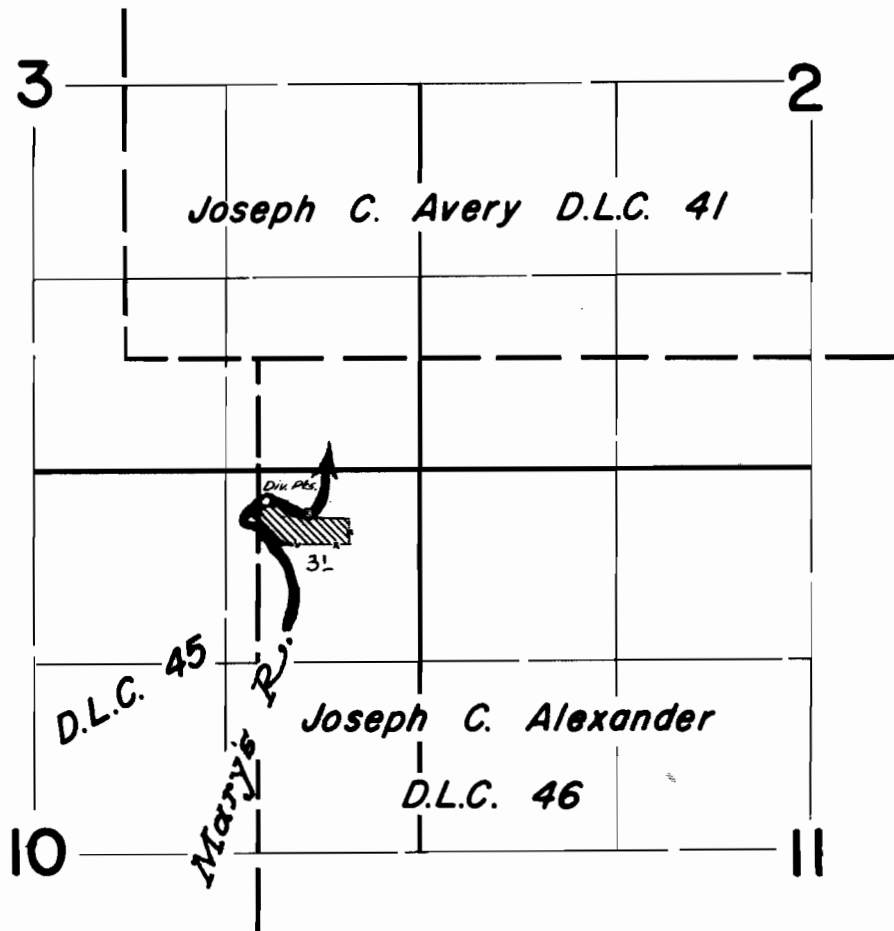

## FINAL PROOF SURVEY UNDER

Application No. **37010** Permit No. **27558**  
IN NAME OF

**ELMER SCANLAN**

Surveyed *April 22 1963*, by *C. Baker*