


T.I.S.R.7 W.W.M.

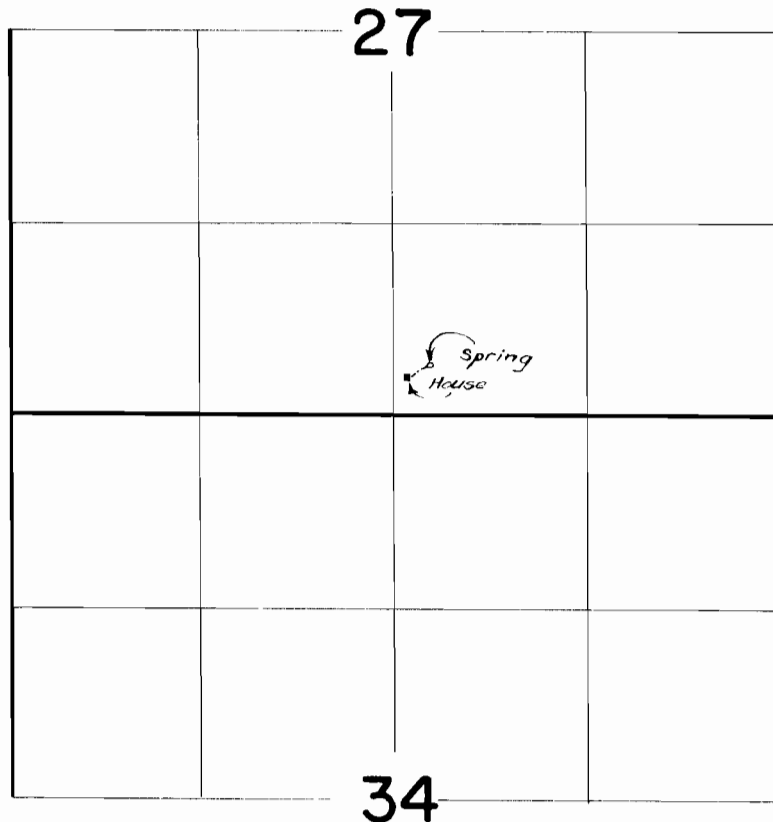

FINAL PROOF SURVEY
UNDER

Application No. **38065** Permit No. **28386**
IN NAME OF

GENE STEPHENS

Surveyed *April 29 1963*, by *C. Baker*

RA