


T.3S. R.1E. W.M.

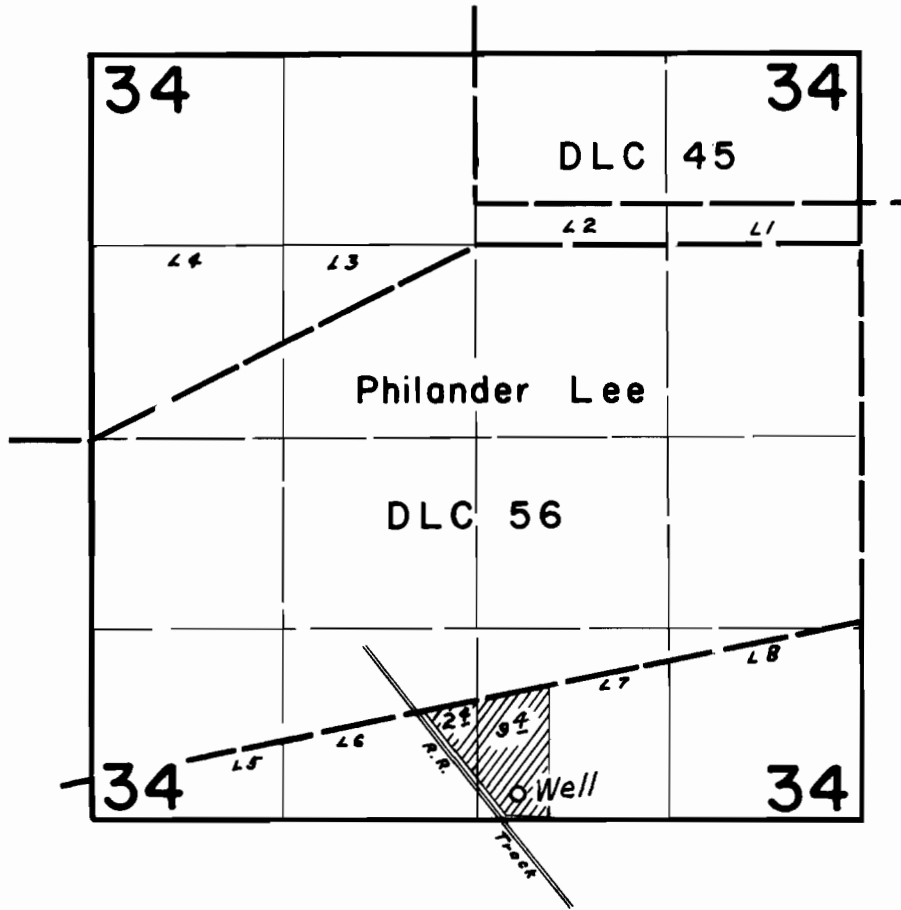

FINAL PROOF SURVEY
UNDER

Application No. G-1839 Permit No. G-1681
IN NAME OF

LEONA MCKENNEY

Surveyed August 10, 1964, by C.J. Gardner.