


T.3S.R.3E.W.M.

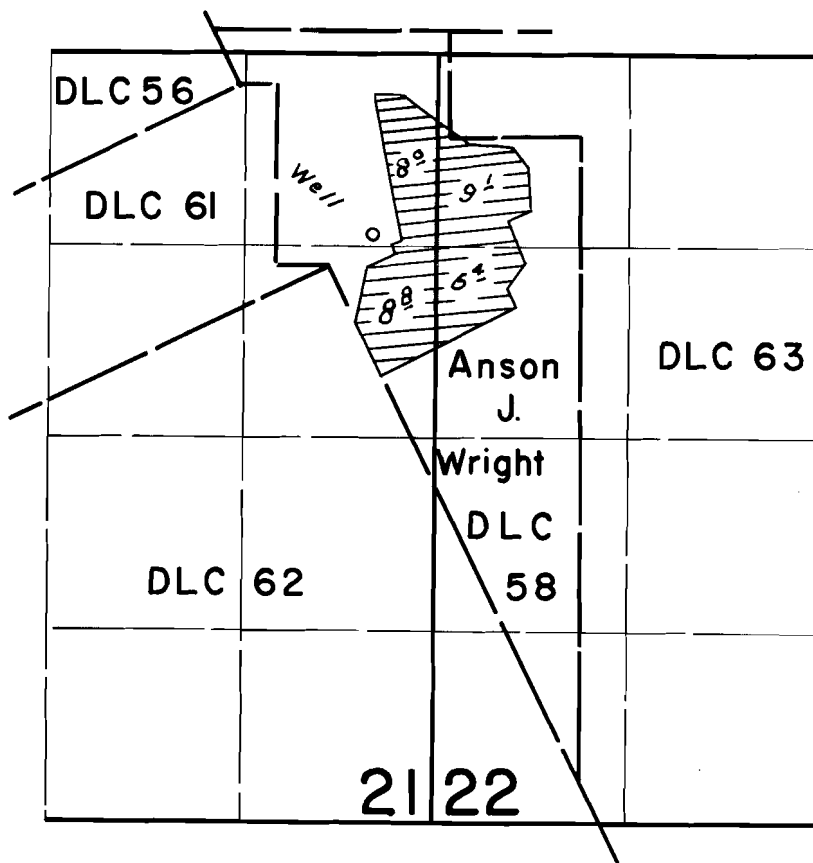

FINAL PROOF SURVEY
UNDER

Application No. G-2079. Permit No. G-1910.....
IN NAME OF

RICHARD POLEHN

Surveyed Sept. 3, 1965., by C.V. Gardner.....