


T.5S. R.1W. W.M.

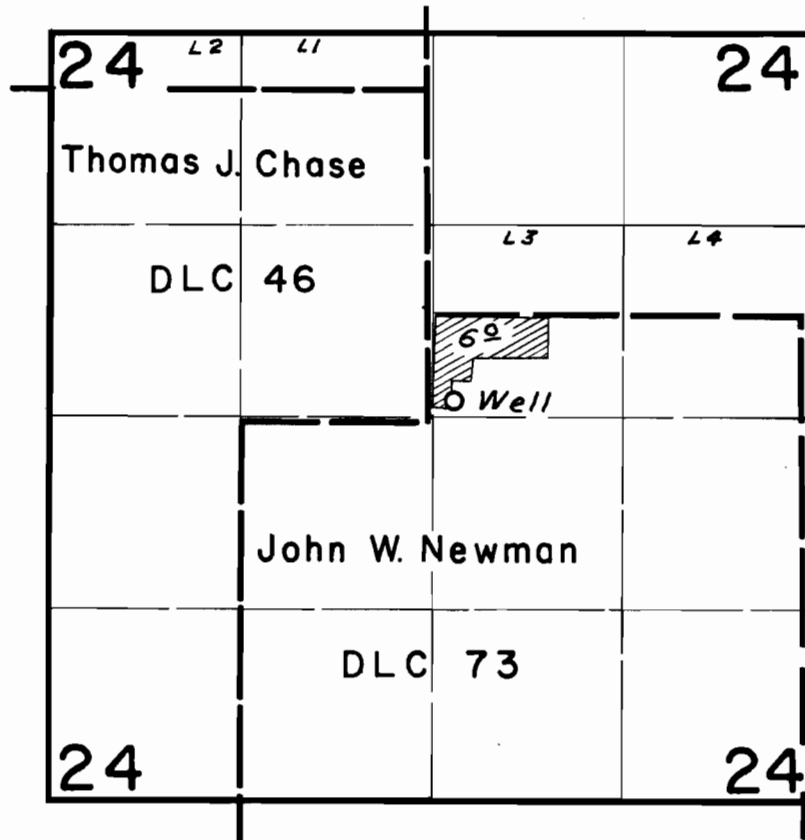

**FINAL PROOF SURVEY**  
UNDER

Application No. G-2427 Permit No. G-2261  
IN NAME OF

**HENRY W. SCHRODER**

Surveyed Sept. 1, 1964, by *C.J. Gardner*