


T. 2 S. R. 2 E. W. M.

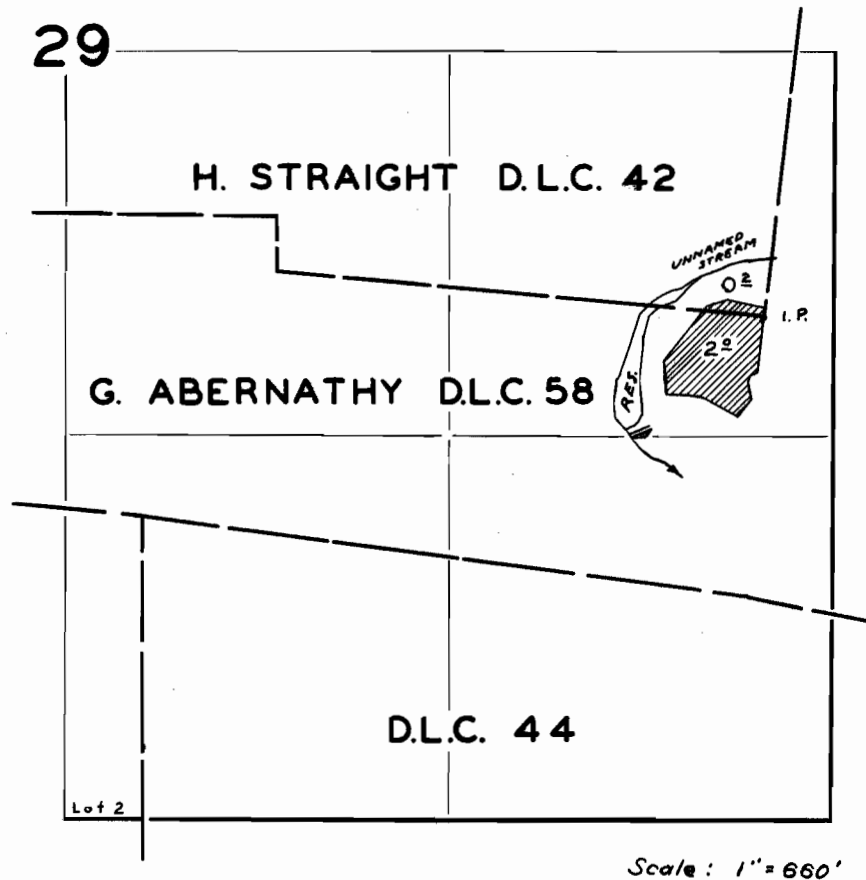

M-18

FINAL PROOF SURVEY
UNDER

Application No. R-37004
35111 Permit No. R-2658
27544
IN NAME OF

ORVILLE A. YOUNG

Surveyed JUNE 19, 1963, by R. JACKSON