


T.2S.R.2E.W.M.

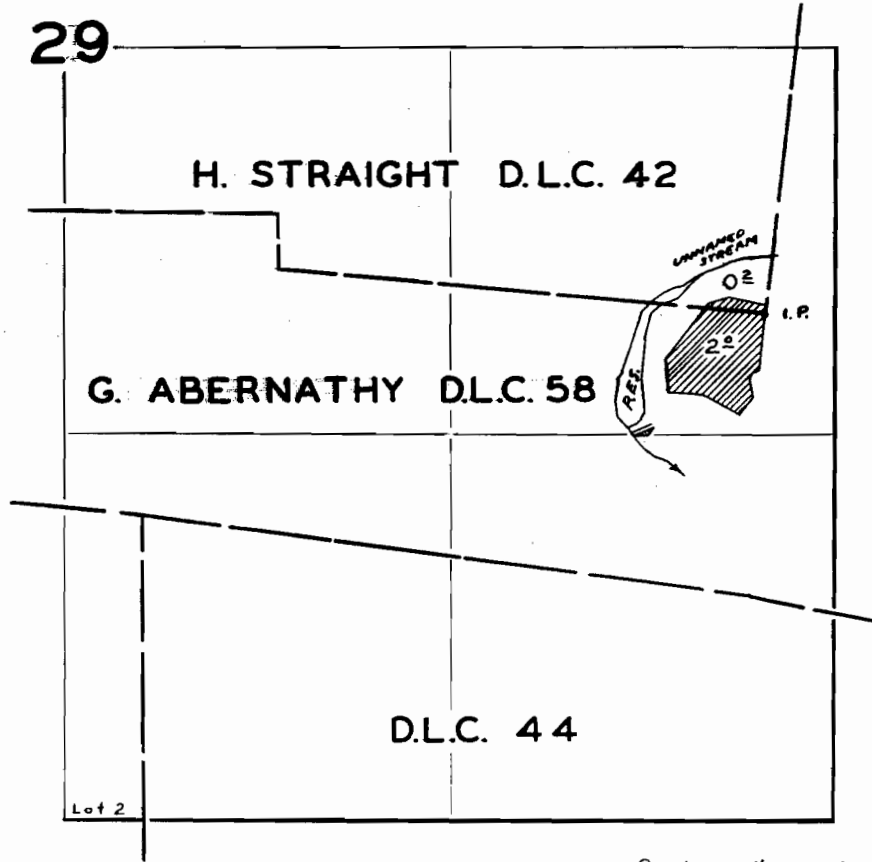

M-18

FINAL PROOF SURVEY
UNDER

Application No. R-37004 35111 Permit No. R-2658 27544

IN NAME OF

ORVILLE A. YOUNG

Surveyed JUNE 19 1963, by R. JACKSON