


T.4S. R.1E. W.M.

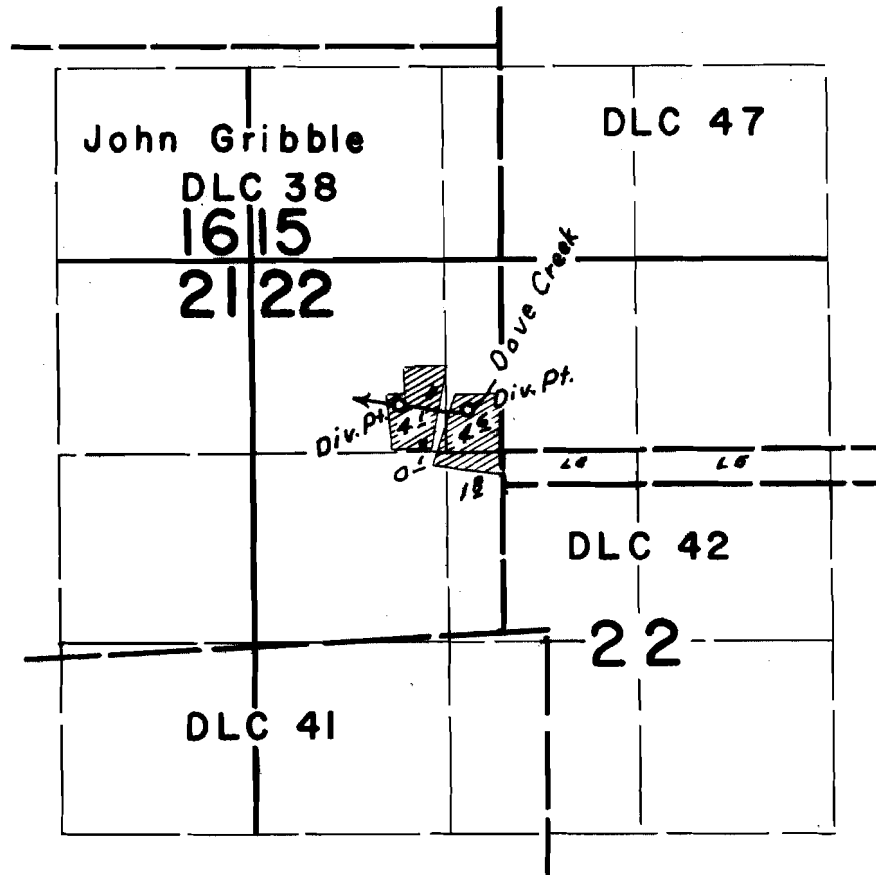

**FINAL PROOF SURVEY**  
UNDER

Application No. 38064 Permit No. 28385  
IN NAME OF

**PAUL J. GRAND**

Surveyed August 31, 1964, by C.J. Gardner