


The sketch below is made solely for the purpose of assisting in locating said premises and the Company assumes no liability for variations, if any, in dimensions and location ascertained by actual survey.



82 ND. ST.

S.P. RR.

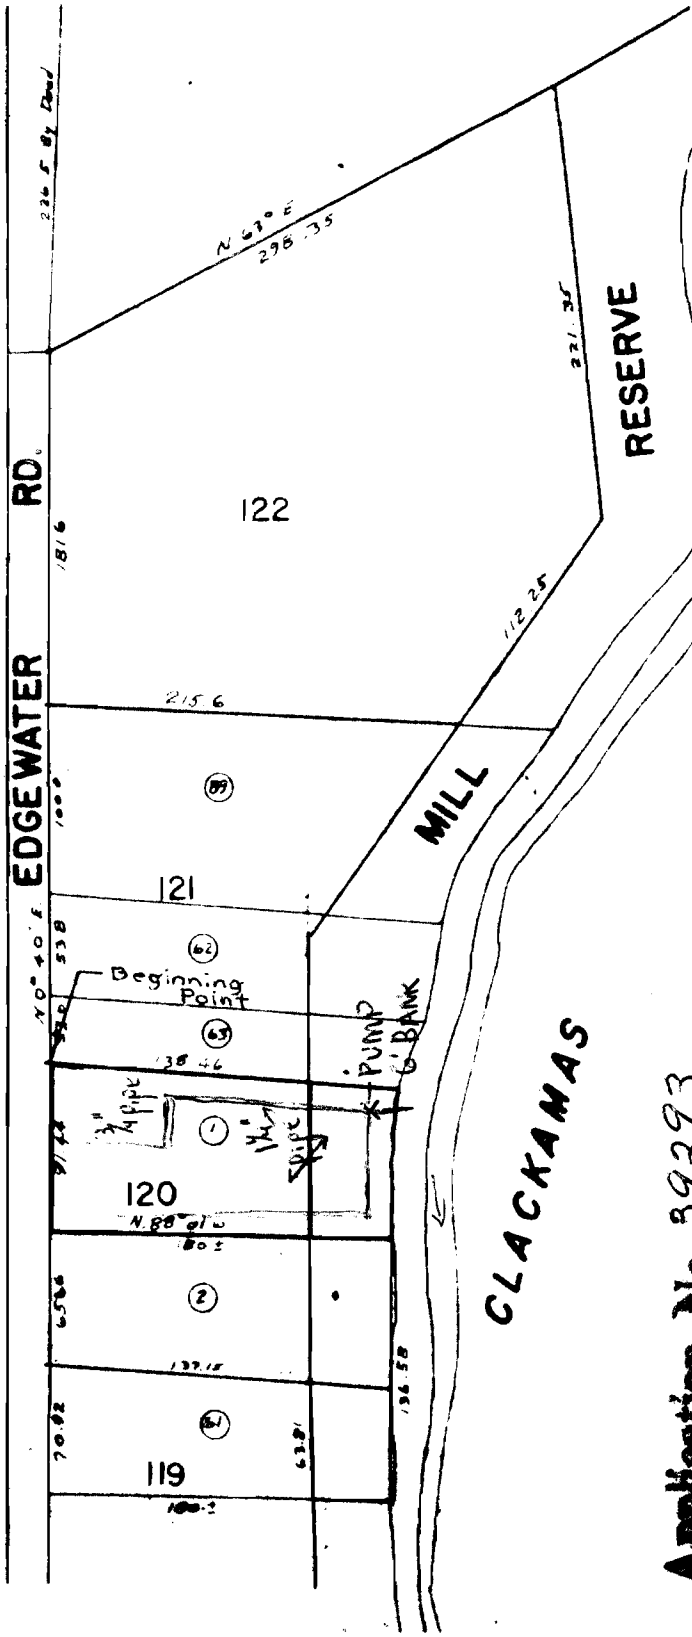

Application No. 39293  
 Permit No. 29262