


T.31S.R.12W.W.M.

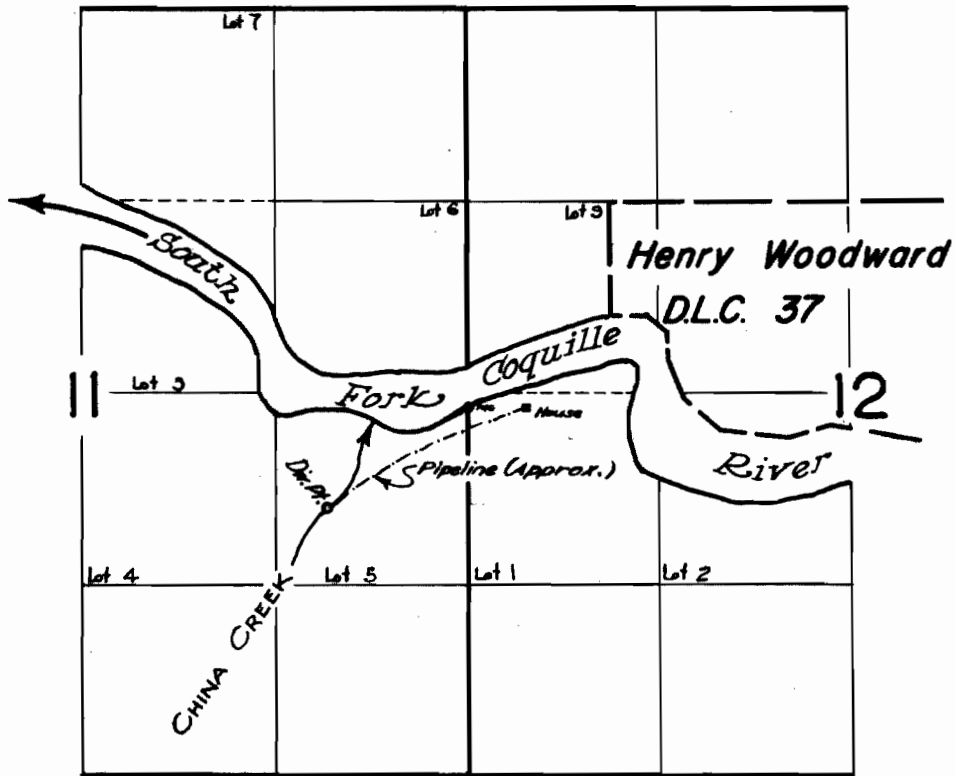

**FINAL PROOF SURVEY
UNDER**

Application No. 31123..... Permit No. 24517.....
IN NAME OF

MR. & MRS. COURTLAND ELLIS

Surveyed August 9 1963, by C. Baker.....