


T.27S.R.12W.W.M.

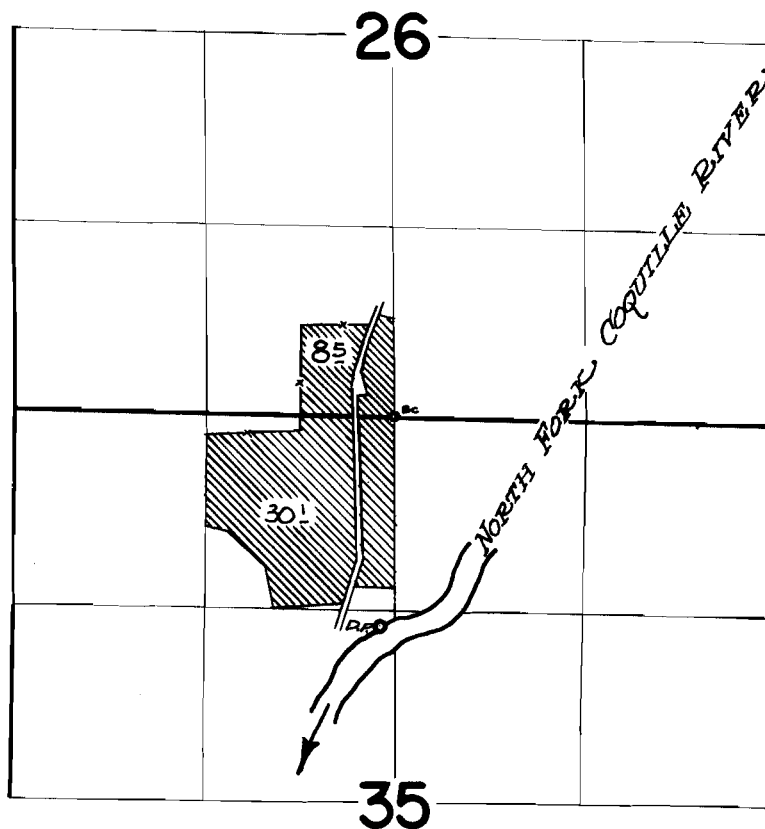

FINAL PROOF SURVEY
UNDER

Application No. 32474 Permit No. 25641
IN NAME OF

CLIFFORD BISSETT

Surveyed August 9 1963, by G. Baker