


T.28-29S. R.14 W.W.M.

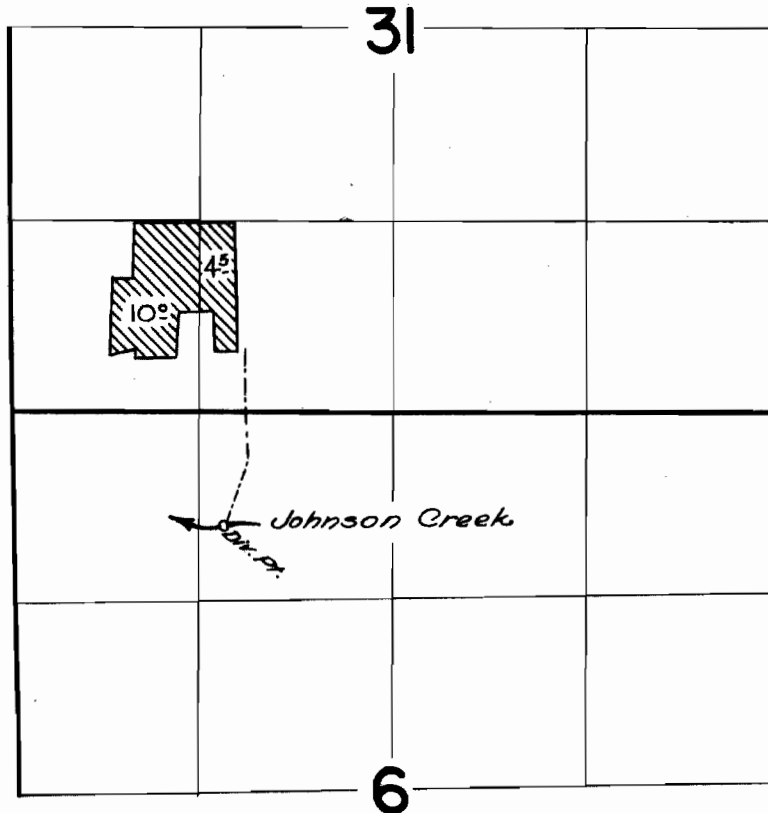

FINAL PROOF SURVEY
UNDER

Application No. 33172... Permit No. 26237...
IN NAME OF

NORTON & DEAN

Surveyed August 13, 1963, by C. Baker.....