


T.28S.R.14W.W.M.

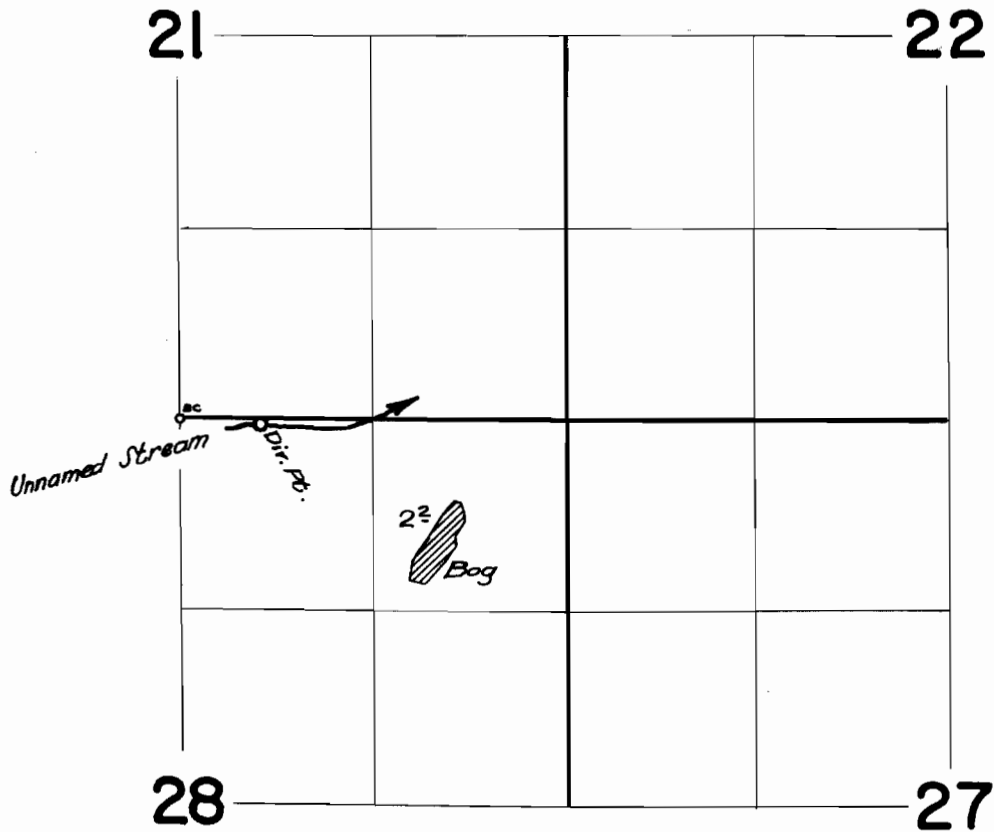

FINAL PROOF SURVEY
UNDER

Application No. **33390** Permit No. **26385**
35211 **27495**...
IN NAME OF

..... **R. W. STRONG**

Surveyed *August 13 1963*, by *R. Baker*.....

et