


Survey Bad -

SE cor of
Trapezoidal piece
should be SE cor
SW $\frac{1}{4}$ NW $\frac{1}{4}$ sec 3

T.28S.R.14W.W.M.

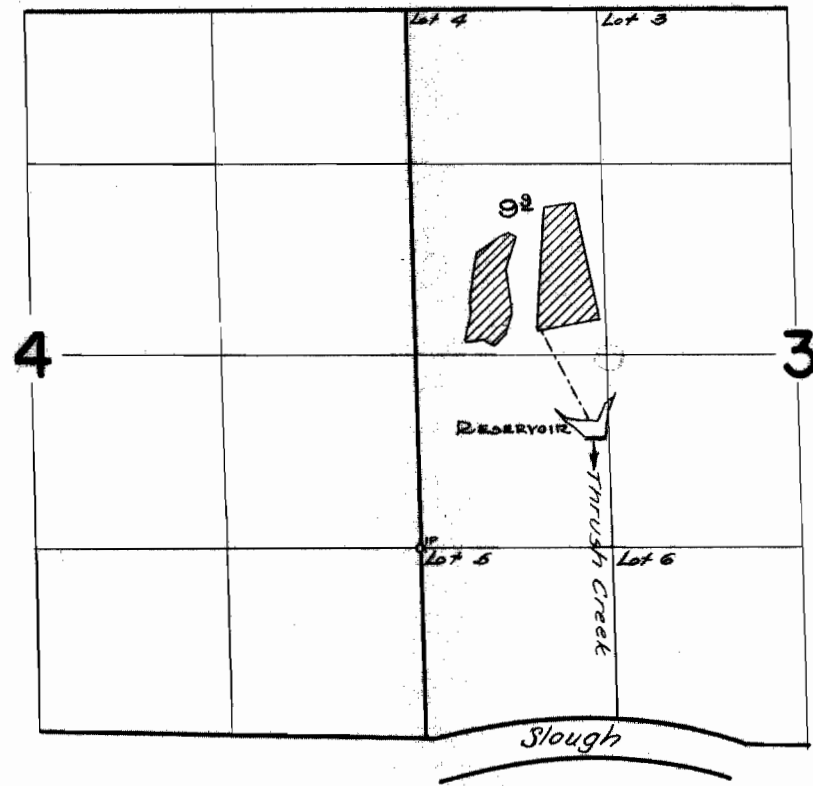

FINAL PROOF SURVEY
UNDER

R-34092 R-2465
Application No. 34093 Permit No. 26926
IN NAME OF

DONALD E. HULTIN

Surveyed August 12 1963, by C. Baker