


T.29S.R.12W.W.M.

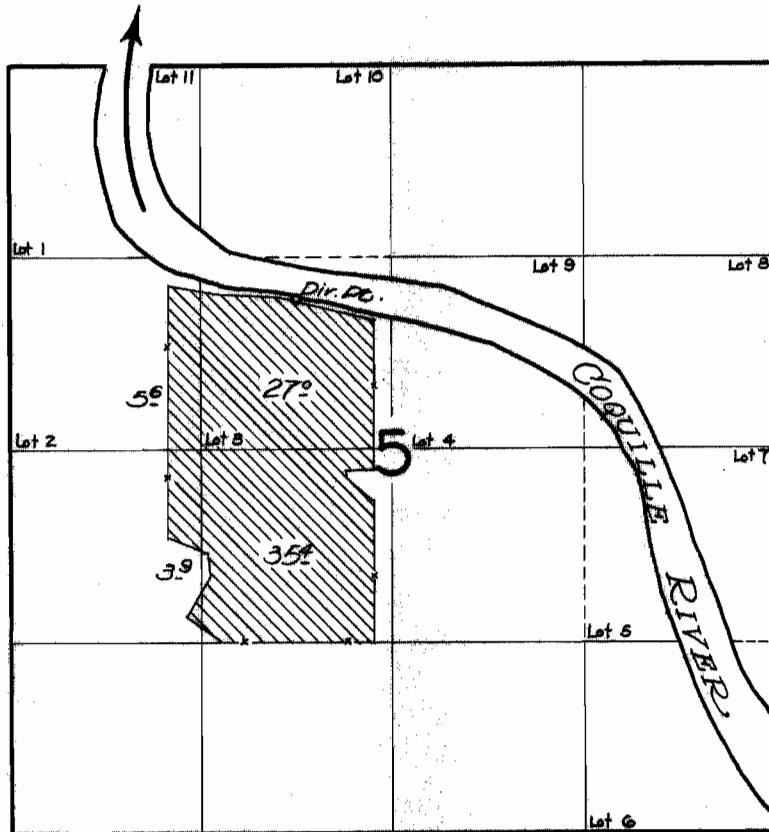

FINAL PROOF SURVEY
UNDER

Application No. 34496 Permit No. 27086
IN NAME OF

FRED E. & GLADYS A. DEVERAUX

Surveyed August 8, 1963, by C. Baker