


T.28S.R.IIW.W.M.

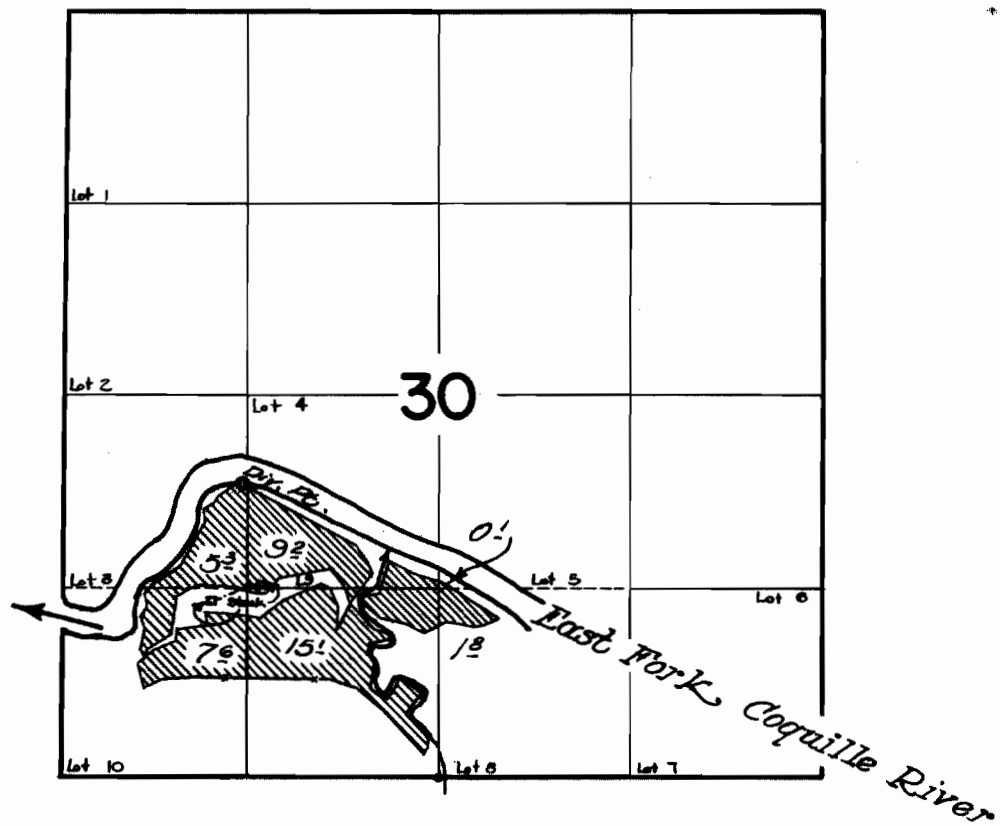

FINAL PROOF SURVEY
UNDER

Application No. 34671... Permit No. 27231...
IN NAME OF

.....**WALTER L. ELLIOTT**.....

Surveyed August 7, 1963, by C. Baker.....