


T.28S.R.14W.W.M.

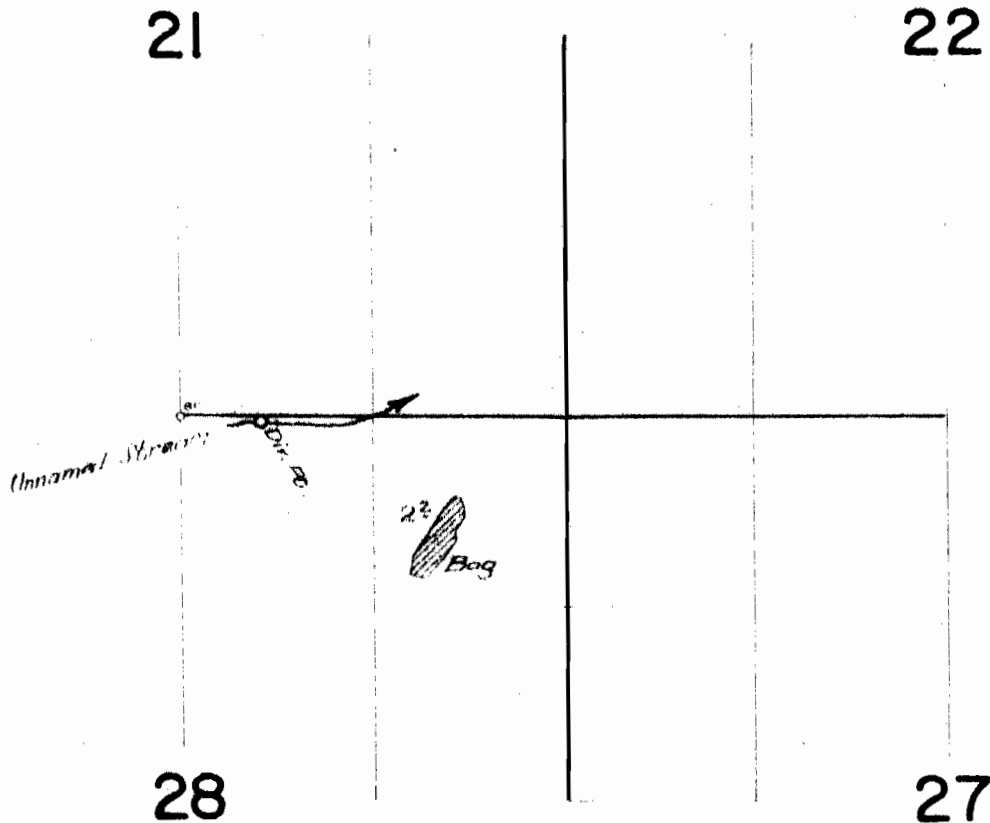

FINAL PROOF SURVEY
UNDER

Application No. **33390** Permit No. **26385**
35211 Permit No. **27495**
IN NAME OF

R. W. STRONG

Surveyed *August 13 1963*, by *C. Baker*