


T.14&15S. R.16E. W.M.

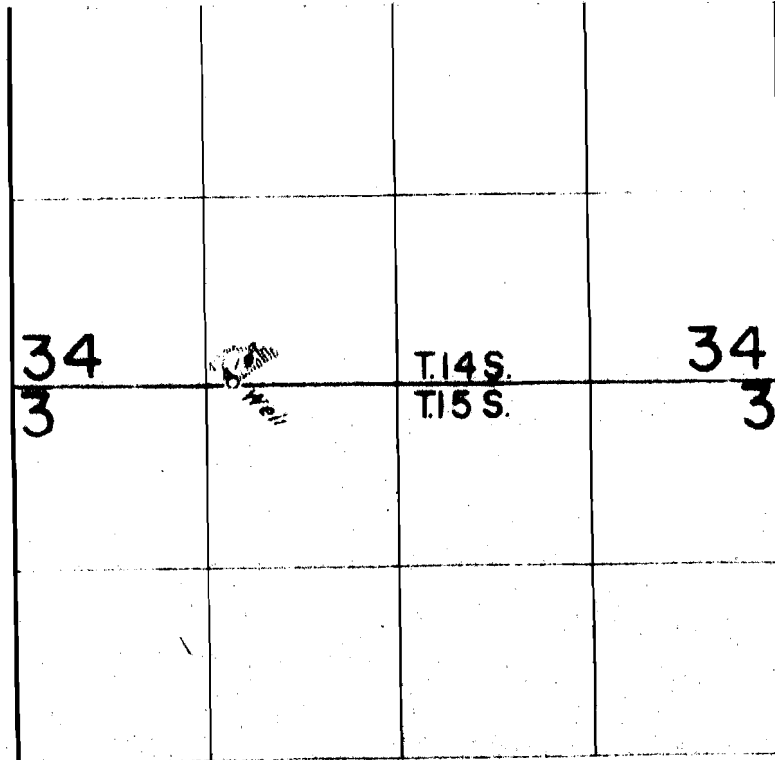

FINAL PROOF SURVEY
UNDER

Application No. G 1675 Permit No. G 1547
IN NAME OF

LAWRENCE C. DEMARIS

Surveyed Sept. 30, 1964, by *C.J. Gordner*

9-1547
1964-P