


T.14S. R.19E. W.M.

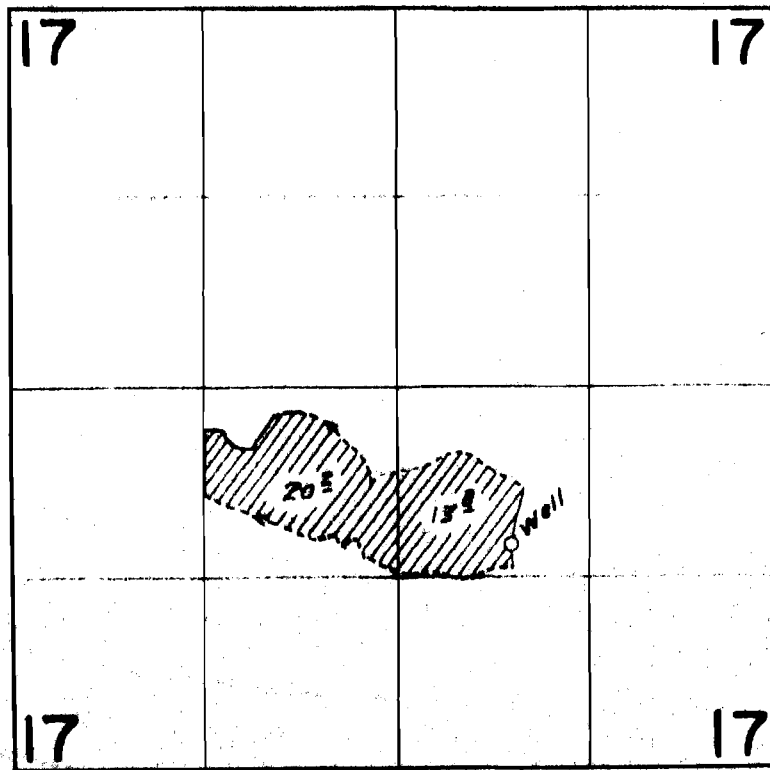

FINAL PROOF SURVEY
UNDER

Application No. G-2119 Permit No. G-1953
IN NAME OF

WILLIAM H. TACKMAN

Surveyed OCT. 3, 1964, by C. J. Gardner

9-1953
OCT 11 1964