


T14S. R.16E. W.M.

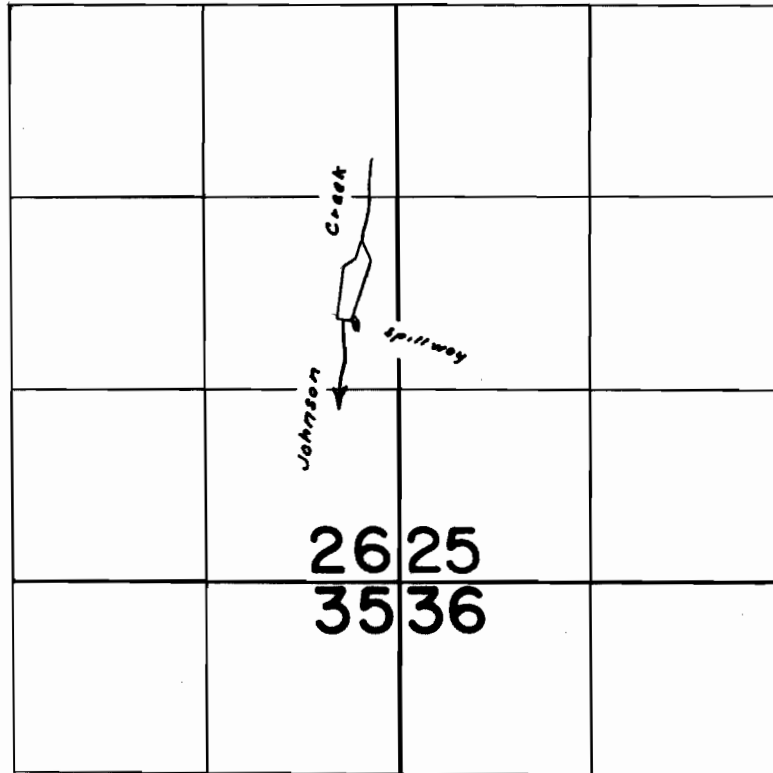

**FINAL PROOF SURVEY**  
UNDER

R-31954                      R-2089  
Application No. 31877    Permit No. 25150  
IN NAME OF

**MELVIN E. & MARTHA JEAN CRAWFORD**

Surveyed Sept. 30, 1964, by *C.J. Gardner*