


T14S. R.16E. W.M.

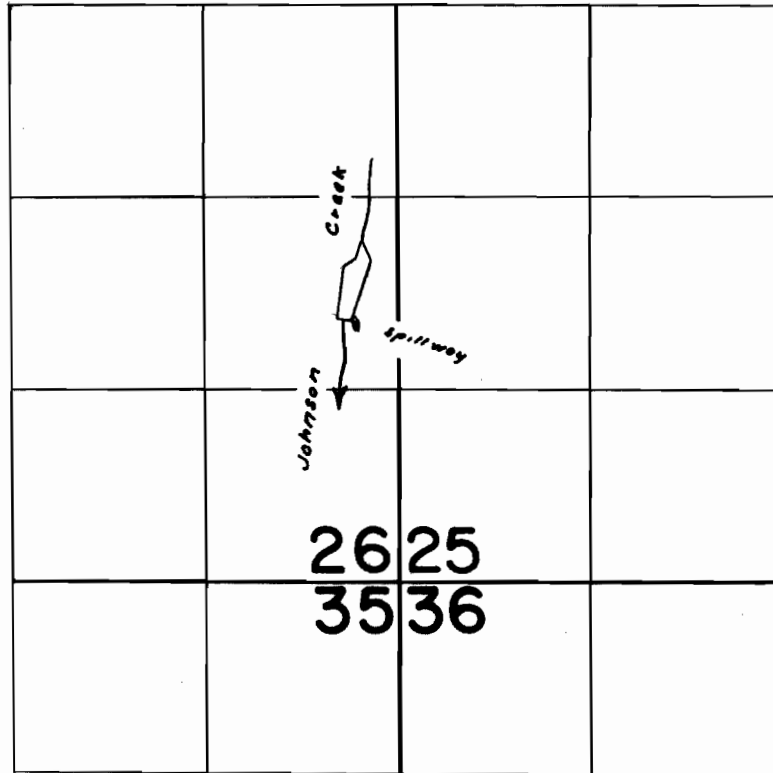

FINAL PROOF SURVEY
UNDER

R-31954 R-2089
Application No. 31877 Permit No. 25150
IN NAME OF

MELVIN E. & MARTHA JEAN CRAWFORD

Surveyed Sept. 30, 1964, by *C.J. Gardner*