


T.16&17S. R.19E. W.M.

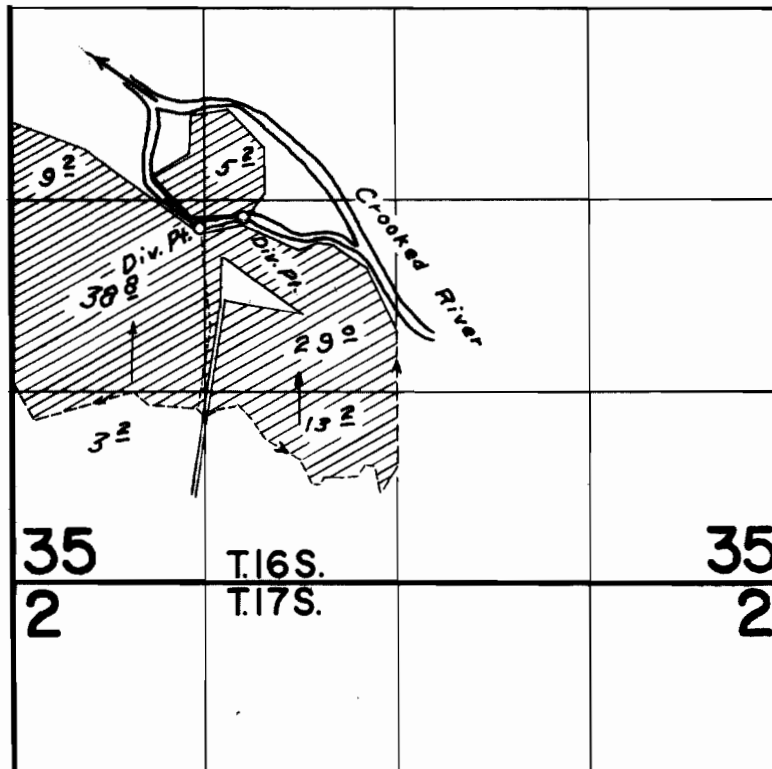

FINAL PROOF SURVEY
UNDER

Application No. 33169 Permit No. 26235
IN NAME OF

DON W. BRUMMER

Surveyed Oct. 2., 1964., by C.J. Gardner